


G-6444


48133  
48134

# T.2S.,R.22E.,W.M.

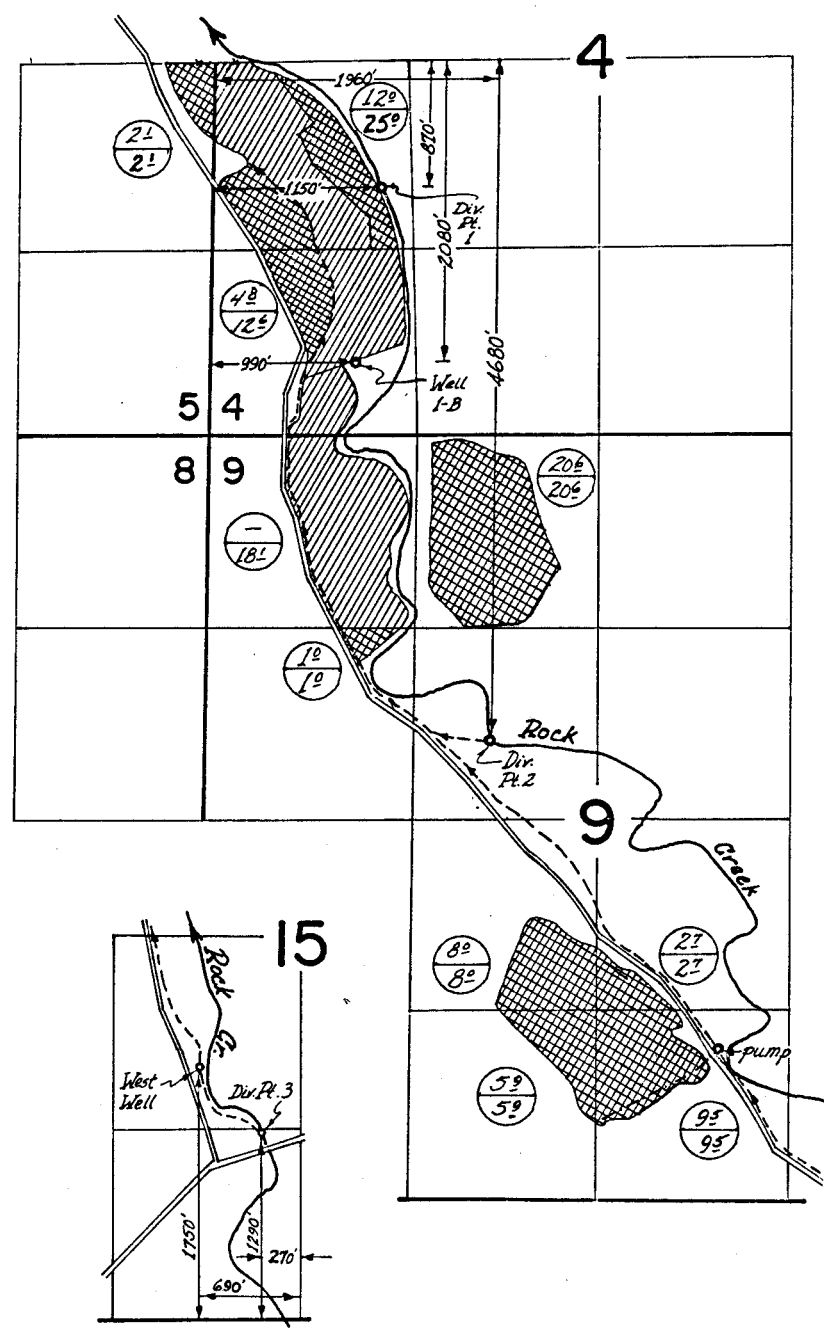

## FINAL PROOF SURVEY UNDER

53596                      39932  
 Application No. G-6926    Permit No. G-6444  
 IN NAME OF

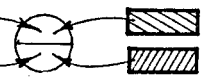

LEE & PATRICIA PETTYJOHN

Surveyed Oct. 26, 1977, by R.G. Mucken