


G-5104
48135

T.13S. R.31E. W.M.

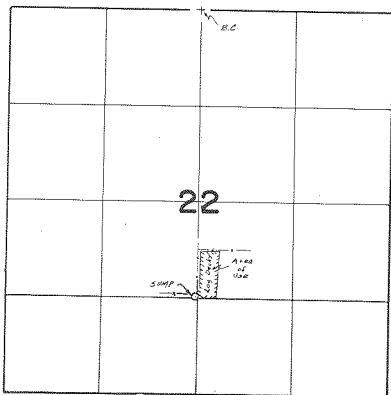

SUMP Loc. 1340 N. 120' W. From S/W Cor. Sec. 22

FINAL PROOF SURVEY UNDER

Application No. G-5251... Permit No. G-5104...
IN NAME OF

..... BLUE MOUNTAIN MILLS, INC.

Surveyed Sept. 16, 1977, by S.C. BROWN.....