


T.23S., R.32 1/2 E., W.M.

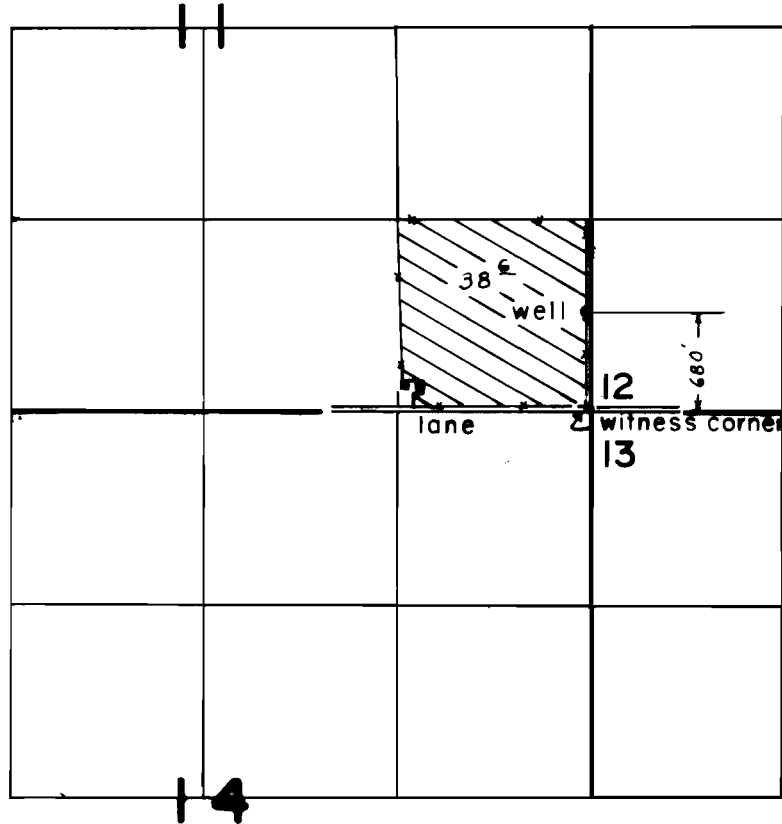

FINAL PROOF SURVEY
UNDER

Application No. G-5859. Permit No. G-5595.
IN NAME OF

ARLA LEE & CATHERINE J. ALLISON

Surveyed OCT. 13. 1977, by L.H. NUNN.....