


T. 34 S., R. 4 W., W.M.

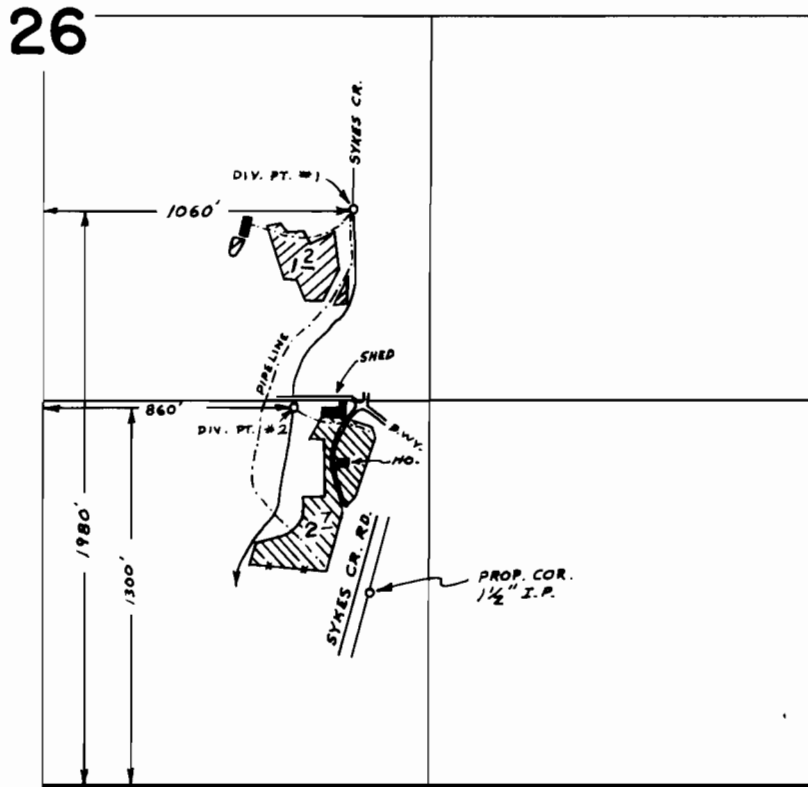

SCALE : 1" = 660 FT.

FINAL PROOF SURVEY UNDER

Application No. 47309 Permit No. 35445
IN NAME OF

Orvin E. Wagner

Surveyed NOV. 14 1978, by B. SUND