


T. 33 S., R. 1 W., W.M.

SEC. 36

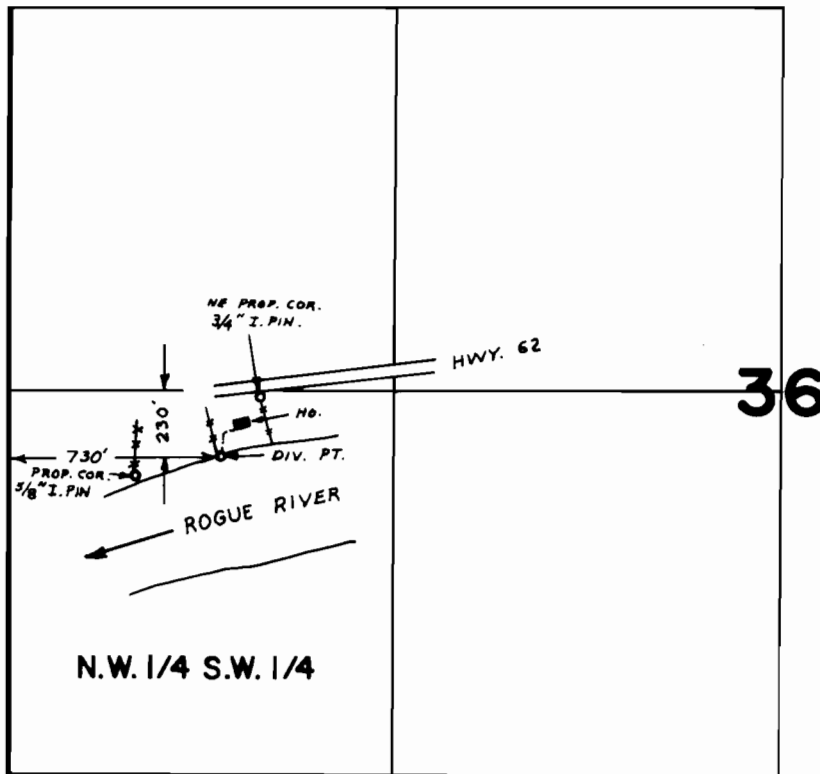

SCALE: 1" = 660 FT.

FINAL PROOF SURVEY UNDER

Application No. 53614 Permit No. 42223
IN NAME OF
HARRY P. & VIOLA M. RITTER

Surveyed AUG. 29 1978, by B. SUND