


T. 32 S., R. 3 E., W.M.

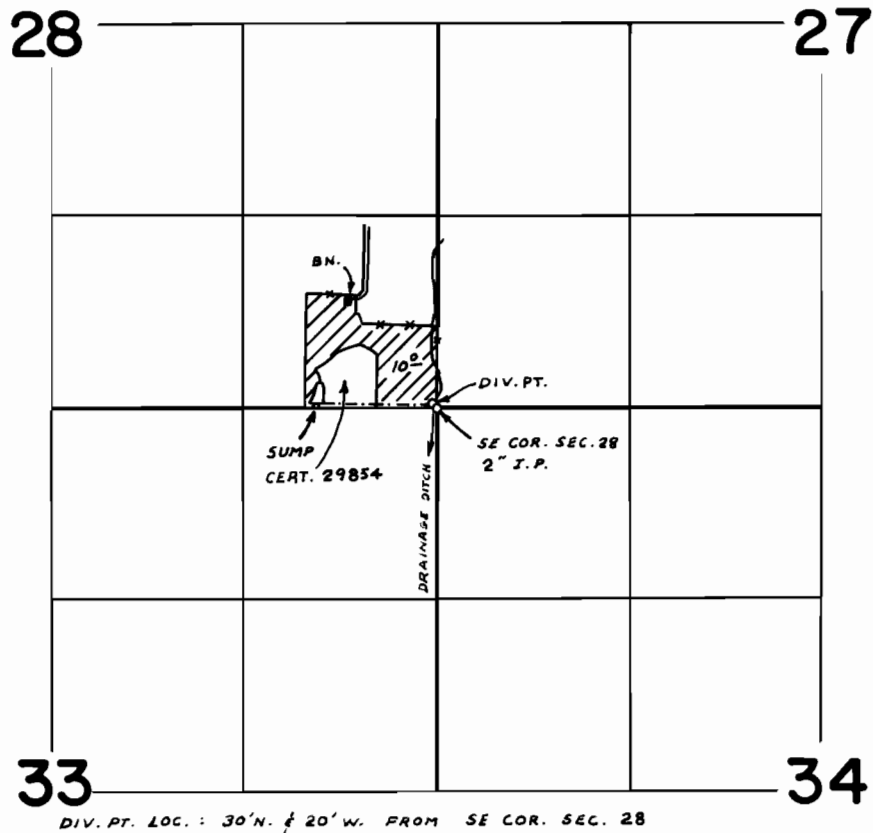

FINAL PROOF SURVEY
UNDER

Transfer No. 3397

Application No. 54167... Permit No. 40551...
IN NAME OF

SAM & SANDRA E. FRICKE

Surveyed AUG. 9 1978, by B. SUND