


T. 33 S., R. 1 W., W.M.

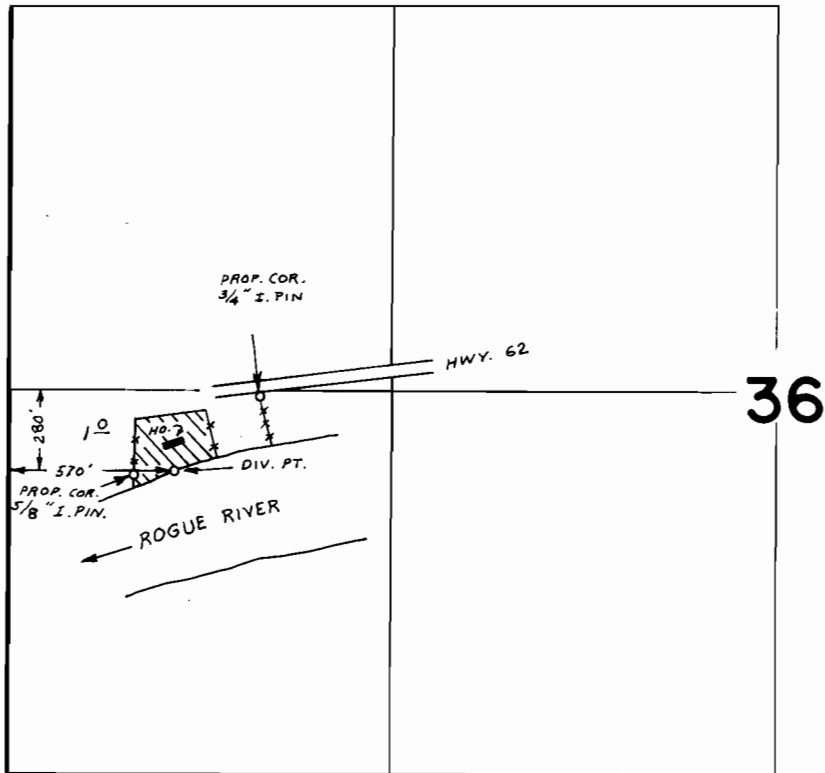

SCALE : 1" = 660 FT.

FINAL PROOF SURVEY
UNDER

Application No. 56682 Permit No. 42055
IN NAME OF

ROBERT E. CHANDLER

Surveyed AUG. 29 1978, by B. SUND