


T.36S., R.3W., W.M.

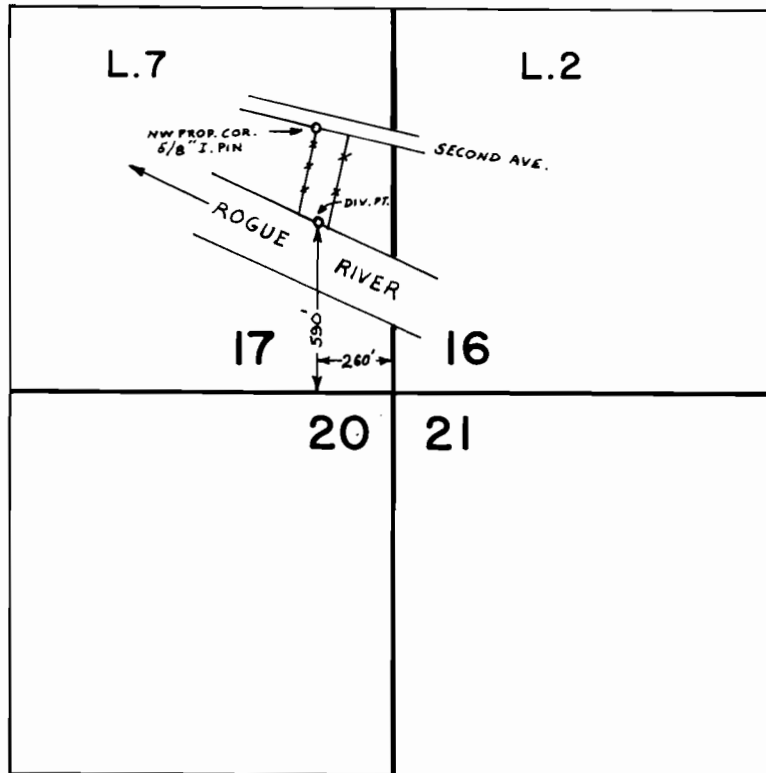

SCALE: 1" = 660 FT.

**FINAL PROOF SURVEY**  
UNDER

Transfer No. 3259

Application No. .... Permit No. ....

IN NAME OF

C. G. & LEORA M. VAN BLARICOM

Surveyed SEPT. 21 1978, by B. SUND