


T. 32 S., R. 3 E., W.M.

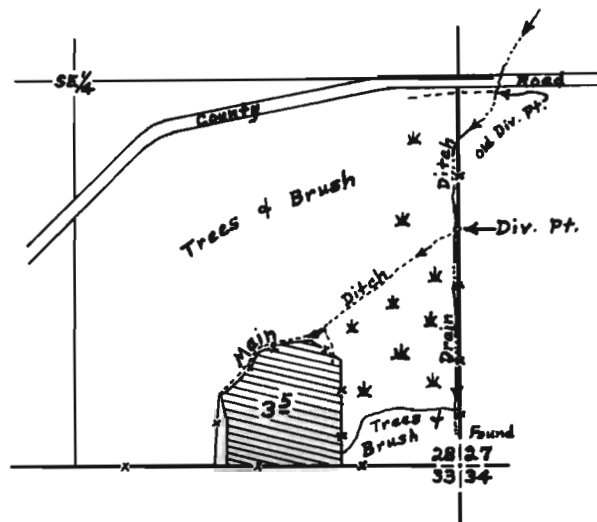

FINAL PROOF SURVEY UNDER

Application No. 22439 Permit No. 17708
IN NAME OF

H. I. Baker

Surveyed 1-11- 1962, by D. L. Hendrix

RECEIVED
JAN 24 1962
STATE ENGINEER
SALEM, OREGON

Scale: 8" = 1 mile