


# T.12S. R.12E. W.M.

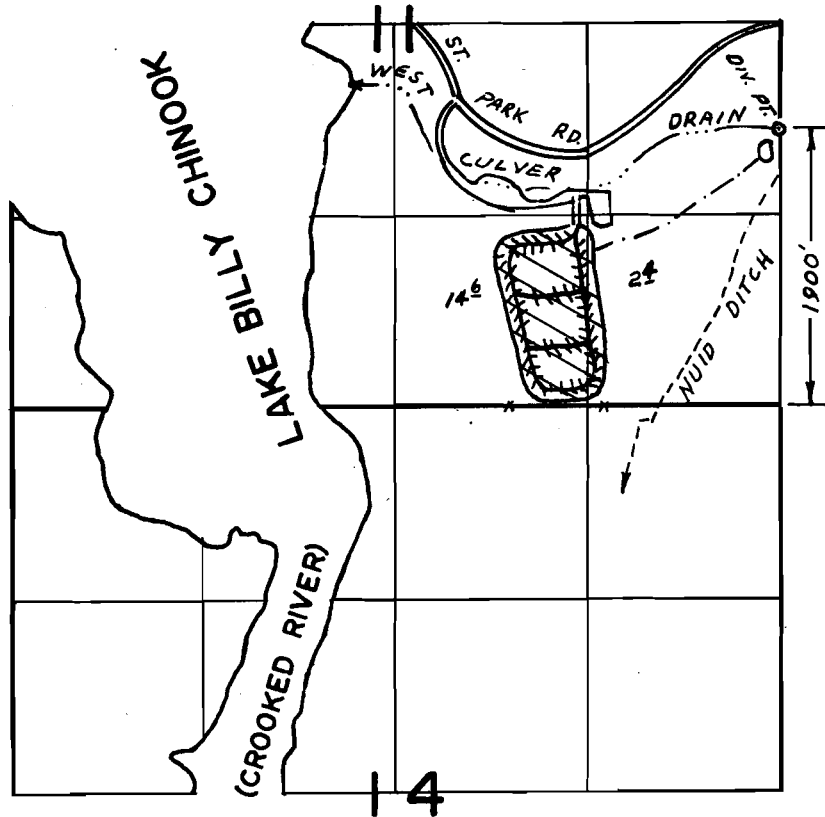

## FINAL PROOF SURVEY UNDER

Application No. 49093... Permit No. 36828...  
IN NAME OF

OREGON STATE PARKS & RECREATION SECTION

Surveyed AUG. 18. 1978. by L.H. NUNN