


T.9S. R.13E. W.M.

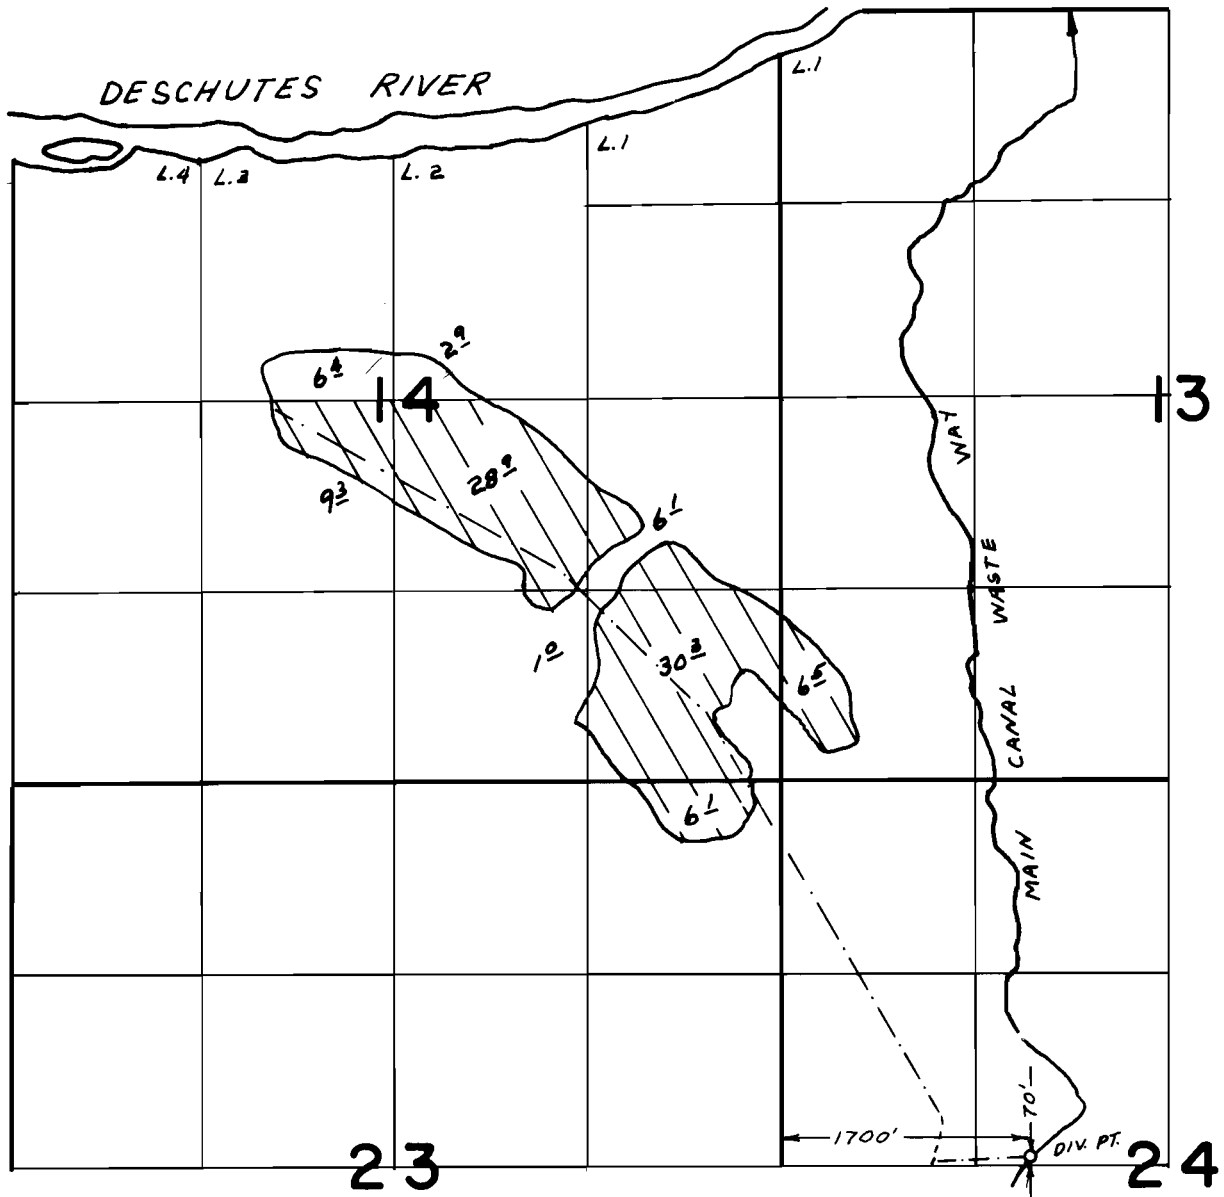

**FINAL PROOF SURVEY**  
UNDER

Application No. 53581... Permit No. 40089...  
IN NAME OF

.....**BARBARA METTEER**.....

Surveyed JUN. 14. 1978, by L.H. NUNN.....