


T.36S., R.5W., W.M.

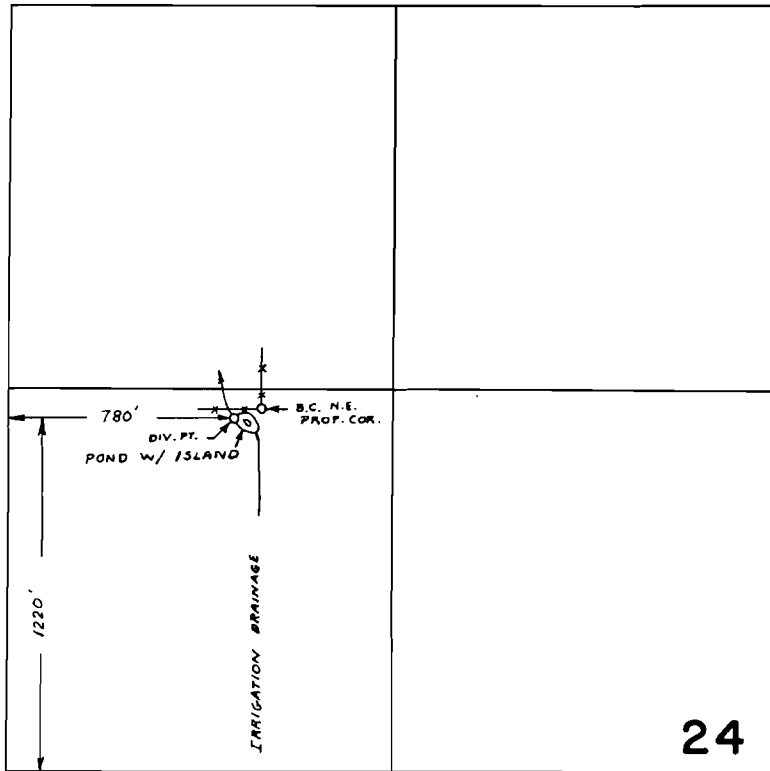

SCALE : 1" = 660 FT.

FINAL PROOF SURVEY UNDER

53527 38056

Application No. R-53401 Permit No. R-6149

IN NAME OF

WILLIAM O. WILLIAMS

Surveyed JUN. 23 1978, by B. SUND