


G 6124
48154

T.27S. R.23E., W.M.

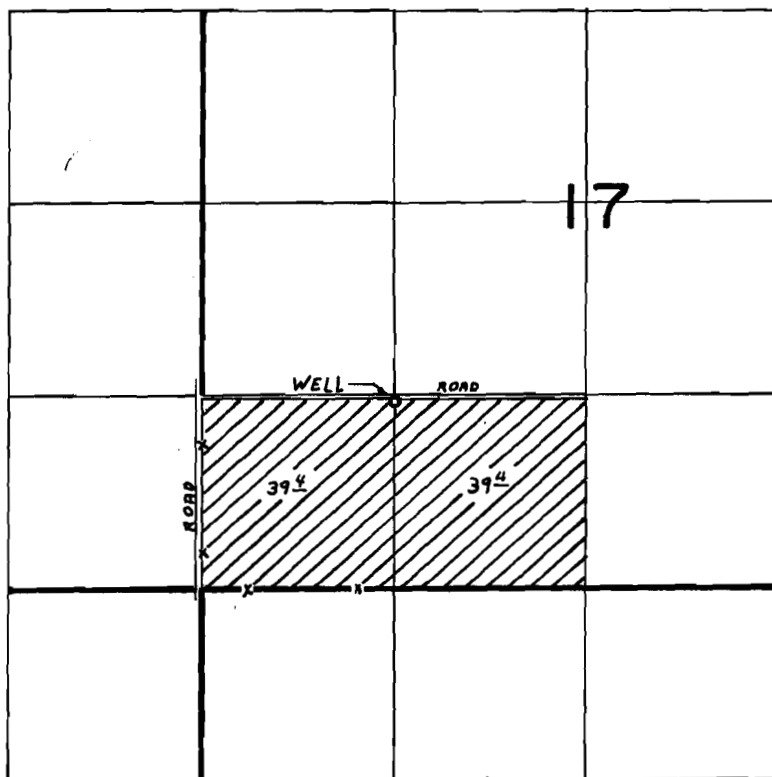

WELL LOC. 1280' N. & 1320' E. FROM S.W. COR. SEC. 17

FINAL PROOF SURVEY
UNDER

Application No. G-6512.... Permit No. G-6124....
IN NAME OF

.....HAY CREEK RANCH.....

Surveyed JUL 21, 1977, by D.M. NORBY.....