


T. 17S., R. 5W., W.M.

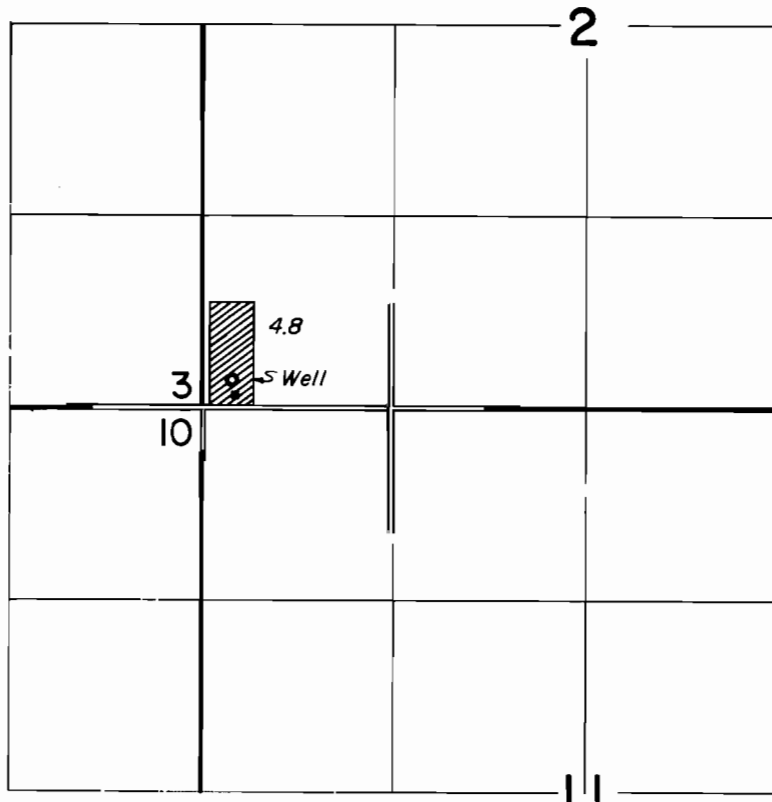

WELL LOC.: 190' N. & 200' E., FROM SW COR. SECTION 2

FINAL PROOF SURVEY
UNDER

Application No. G-8340 Permit No. G-7796
IN NAME OF

GILBERT L. GARRETT

Surveyed MAY 9, 1978, by L. NUNN