


T. 17 S., R. 1 E., W. M.
SEC. 10

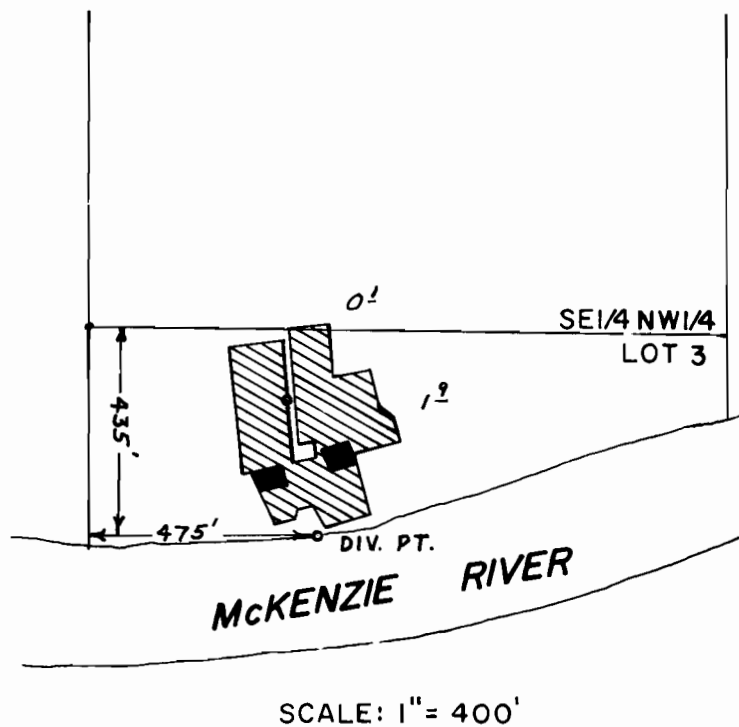

FINAL PROOF SURVEY
UNDER

Application No. 51079... Permit No. 37786...
IN NAME OF
MR. & MRS. ROBERT G. BARKDOLL
THOMAS L. DAHLE.....

Surveyed AUG. 31.. 1977, by L.H. NUNN.....