


T.16 & 17 S., R.2 & 3 E., W.M.

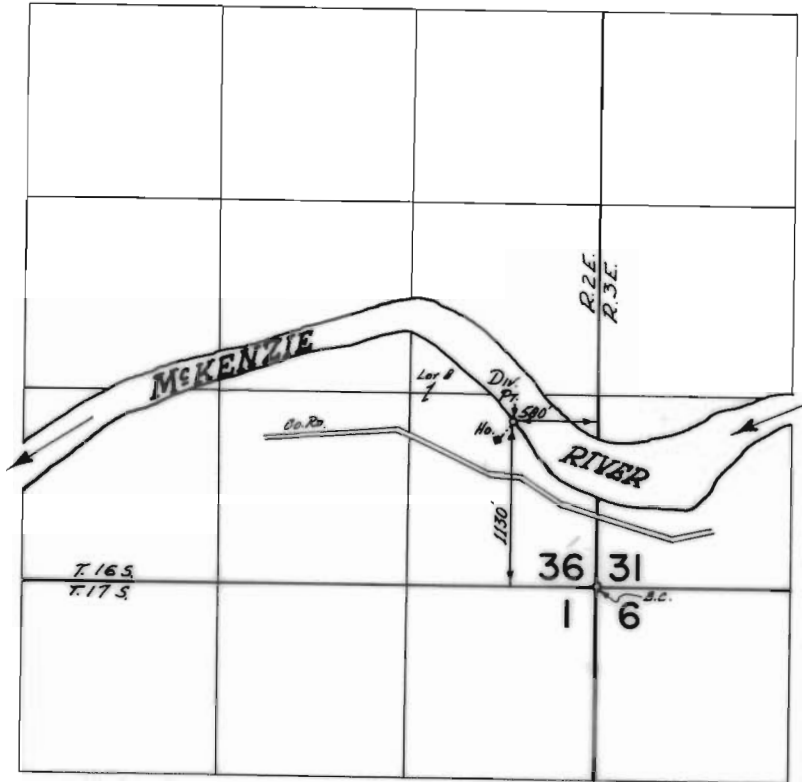

FINAL PROOF SURVEY
UNDER

Application No. 51598 Permit No. 38919
IN NAME OF

DORA WOOD

Surveyed Aug. 18 1977, by L.M. TOLL