


T. 17S., R. 7W., W.M.

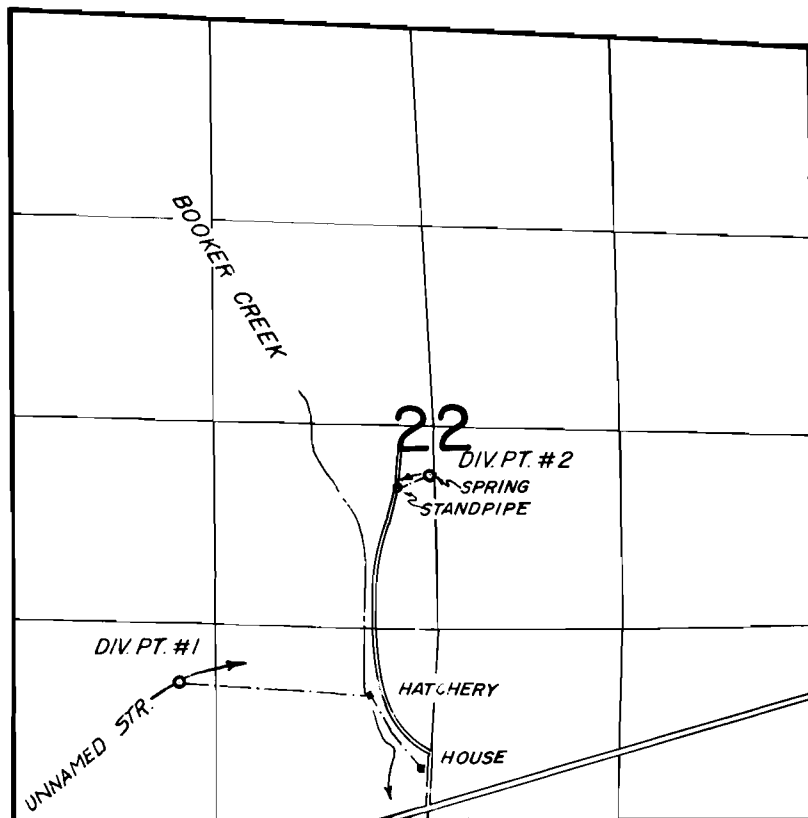

DIV. PTS. LOC.: #1 - 930' N. & 1690' W.; #2 - 2370' N. & 20' E.; BOTH FROM
S. 1/4 COR. SEC. 22

FINAL PROOF SURVEY
UNDER

Application No. 53889 Permit No. 40396
IN NAME OF

LESTER LAKE

Surveyed MAR. 24, 1978, by L. NUNN