


T. 17 S., R. 6 W., W.M.

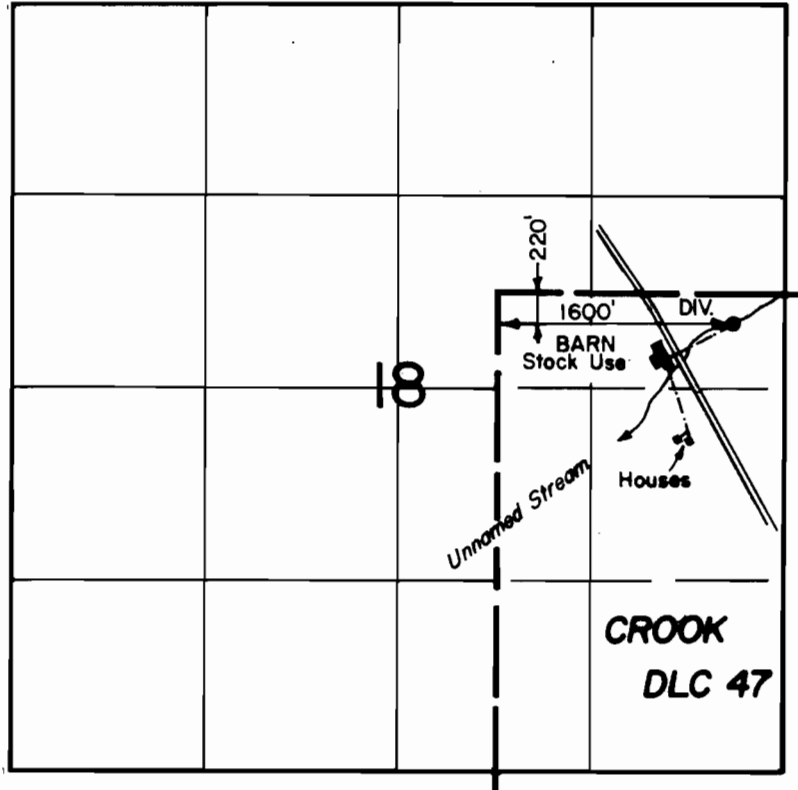

FINAL PROOF SURVEY
UNDER

Application No. 56058 Permit No. 42322
IN NAME OF

W.F. & B. RANEY

Surveyed MAY 25, 1978, by L. NUNN