


T8S. RIOW. WM.

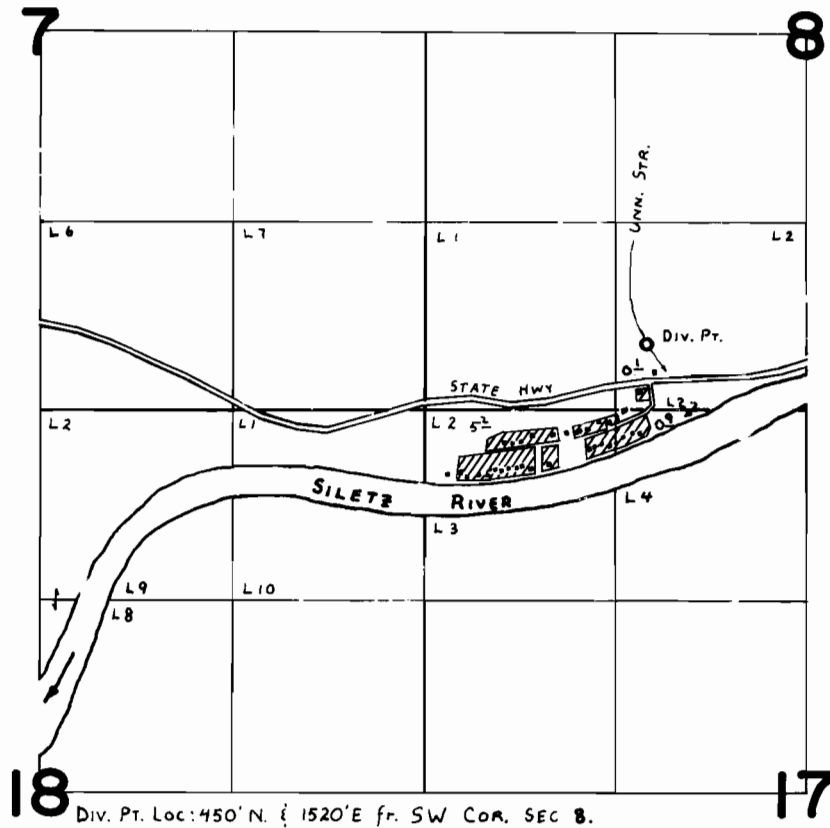

FINAL PROOF SURVEY UNDER

Application No. 35038 Permit No. 27442
IN NAME OF

BALLARD ACRES HOMEOWNERS CORP.

Surveyed MAY 18 1978, by L. H. NUNN