


T. 8S., R. 10W., W.M.

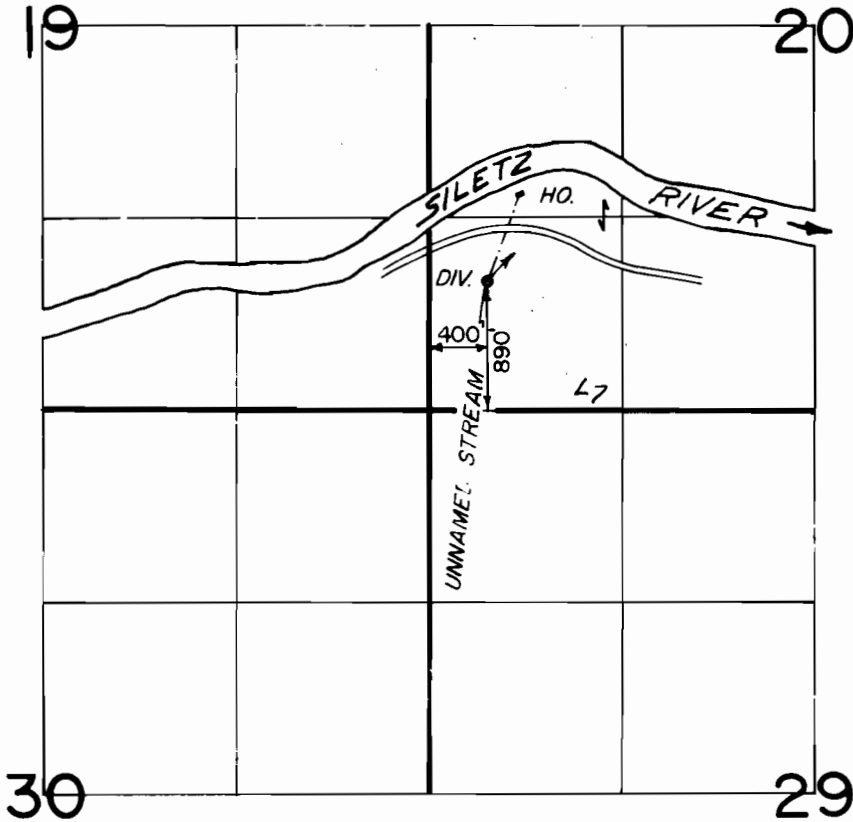

FINAL PROOF SURVEY
UNDER

Application No. 46630 Permit No. 34844
IN NAME OF

Fred P.H. & Wilma M. Clyde

Surveyed May 18, 1978 by L. Nunn