


T. 6 S., R. 10 W., W.M.

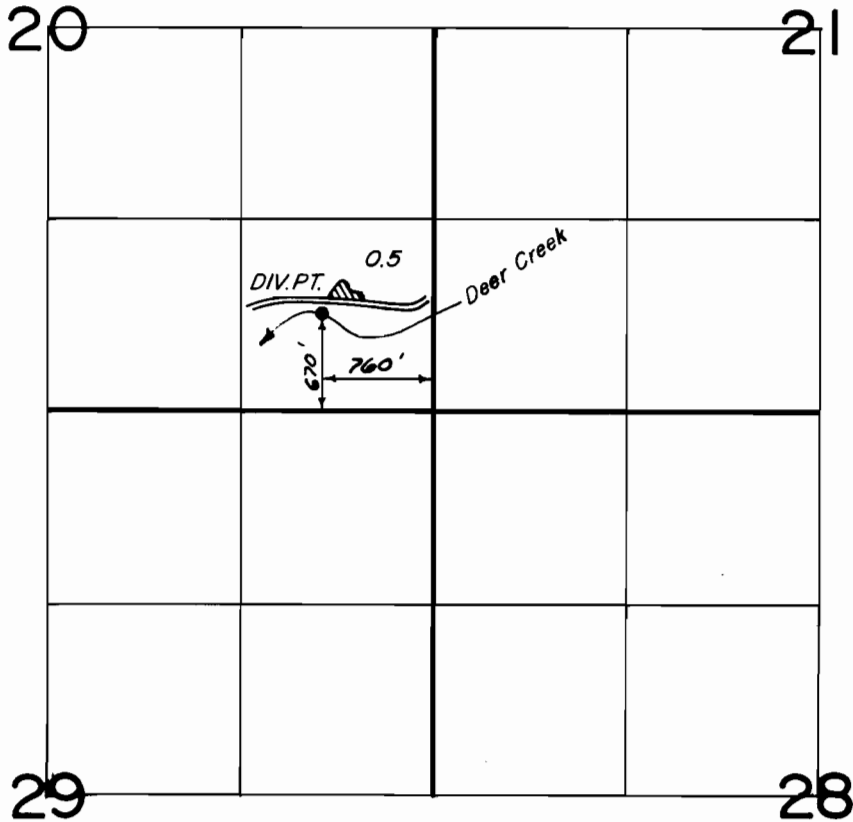

FINAL PROOF SURVEY
UNDER

Application No. 56099 Permit No. 42303

IN NAME OF

D.R. & M.C. Phelps

Surveyed May 19, 1978 by L. Nunn