


T.10S., R.2W., W.M.

*Surveyed
6-2-79*

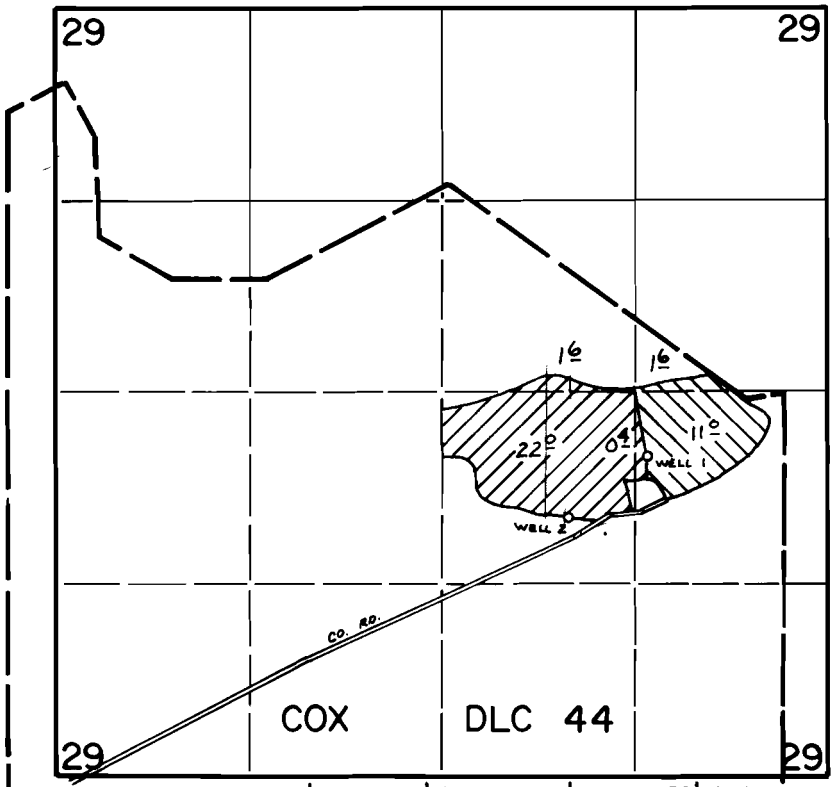

WELLS LOC: 1-2200' N & 1230' W; 2-1780' N & 1770' W both from SE cor. sec. 29

 Well 1
 Well 2

FINAL PROOF SURVEY UNDER

Application No. G-5419 Permit No. G-5349
IN NAME OF

BLAND K. & RUTH M. SHEFFIELD

Surveyed Oct. 20 1976, by D. Norby