


T.10S., R.3W., W.M.

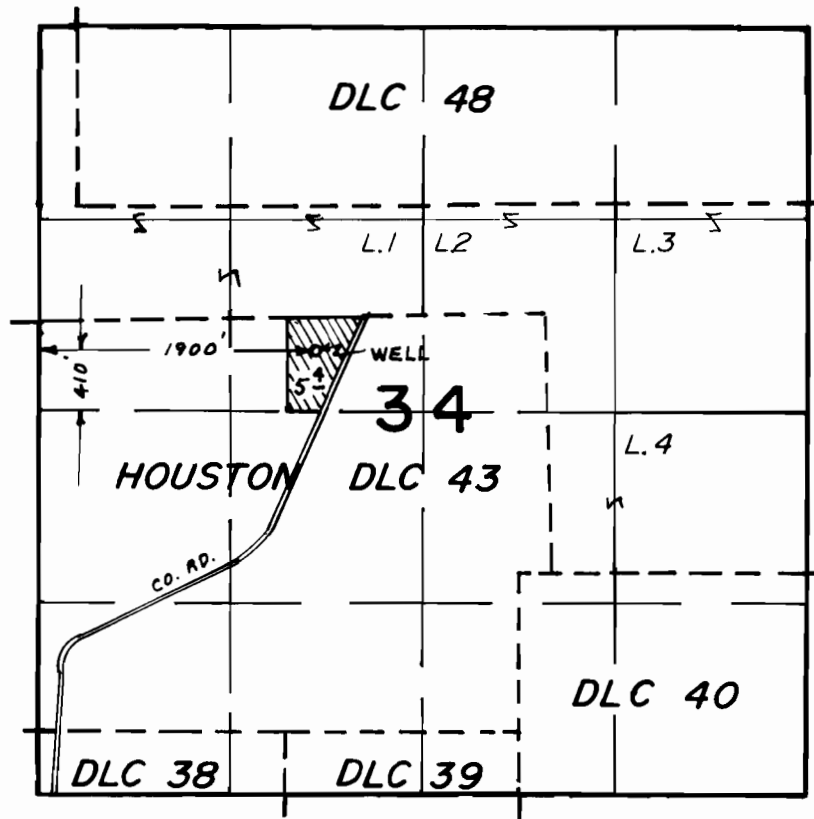

FINAL PROOF SURVEY
UNDER

Application No. G-7117... Permit No. G-6692.
IN NAME OF

JAMES E. BORNEMAN

Surveyed Oct. 3... 1977, by S.C. BROWN...