


# T.18S. R.46E. WM.

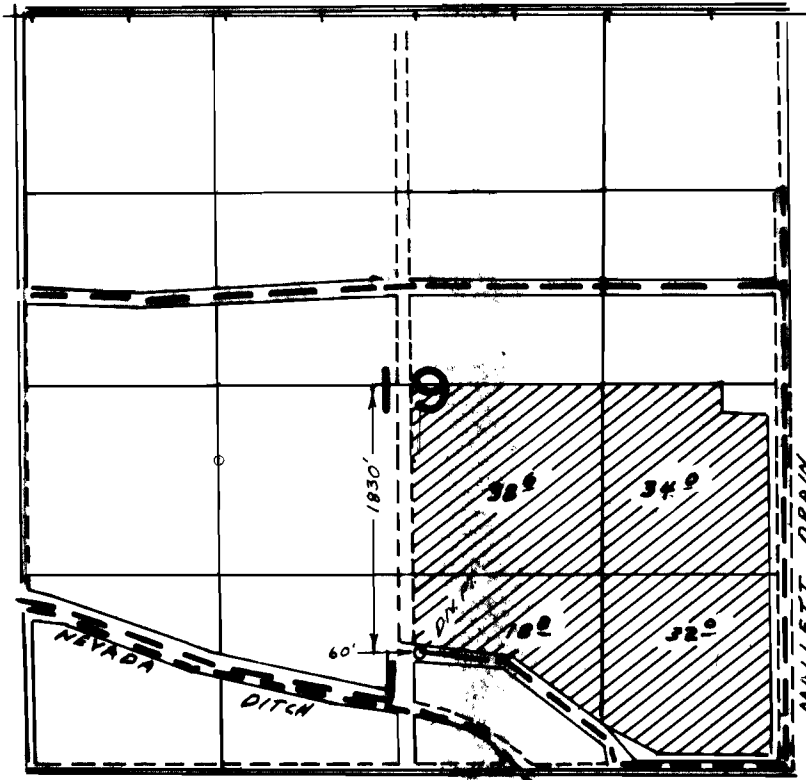

## FINAL PROOF SURVEY UNDER

Application No. 56164... Permit No. 42265...  
IN NAME OF

DONALD WOOD

Surveyed JUN. 22. 1978. by L.H. NUNN