


T.6S., R.1W., W.M.

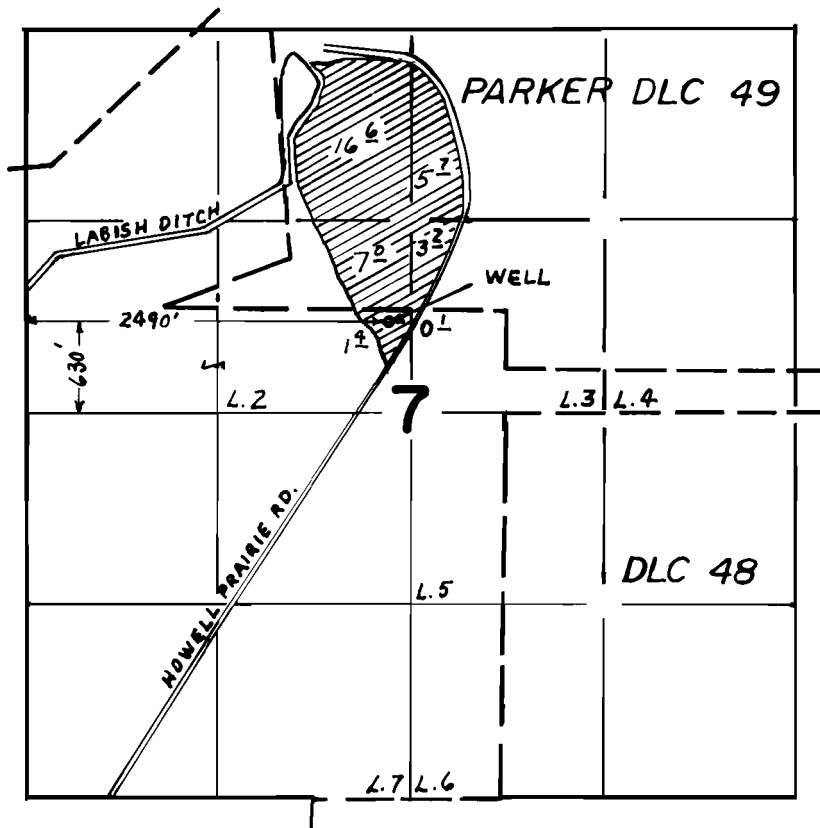

FINAL PROOF SURVEY UNDER

Application No. G-6284. Permit No. G-5914...
IN NAME OF

..... DON M. FOSTER

Surveyed Sept. 6... 1977, by D.M. NORBY.....