


T.5;6S. R.1W. W.M.

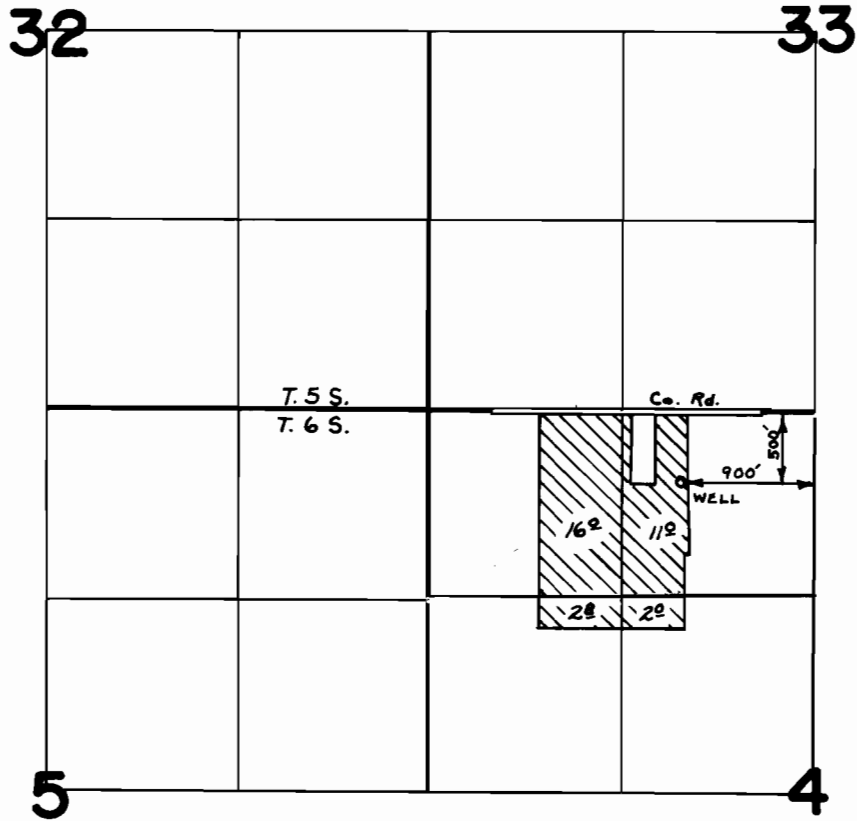

**FINAL PROOF SURVEY**  
UNDER

Application No. G-6927 Permit No. G-6445  
IN NAME OF

RAYMOND A. GRIESENAUER

Surveyed SEPT. 7, 1977, by D. NORBY