


T.7S. R.IE. W.M.

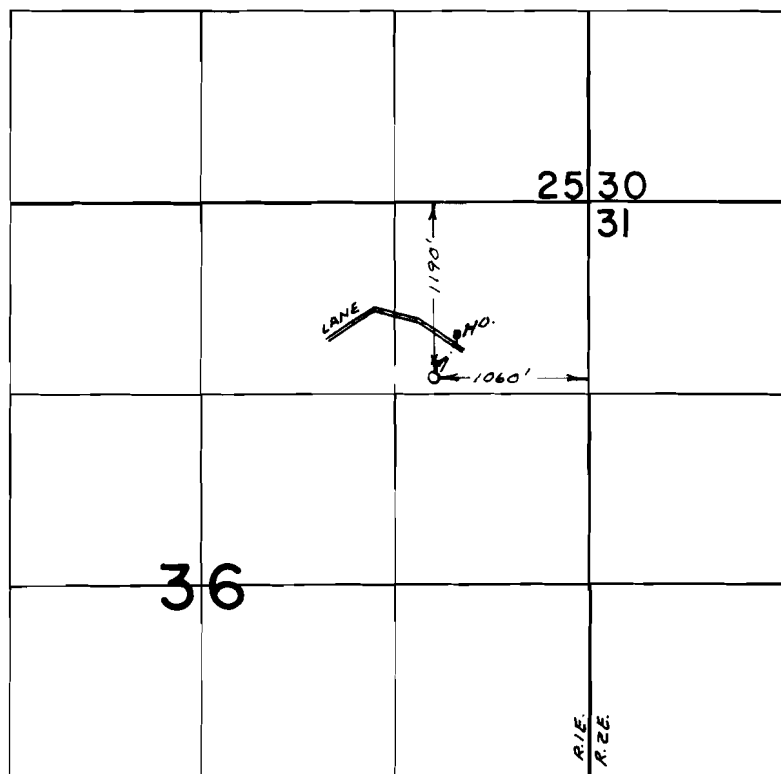

FINAL PROOF SURVEY
UNDER

Application No. 54154..... Permit No. 40682....
IN NAME OF

LLOYD W. PHELPS

Surveyed NOV 10 1977, by L.H. NUNN.....