


T.7S. R.6W. W.M.

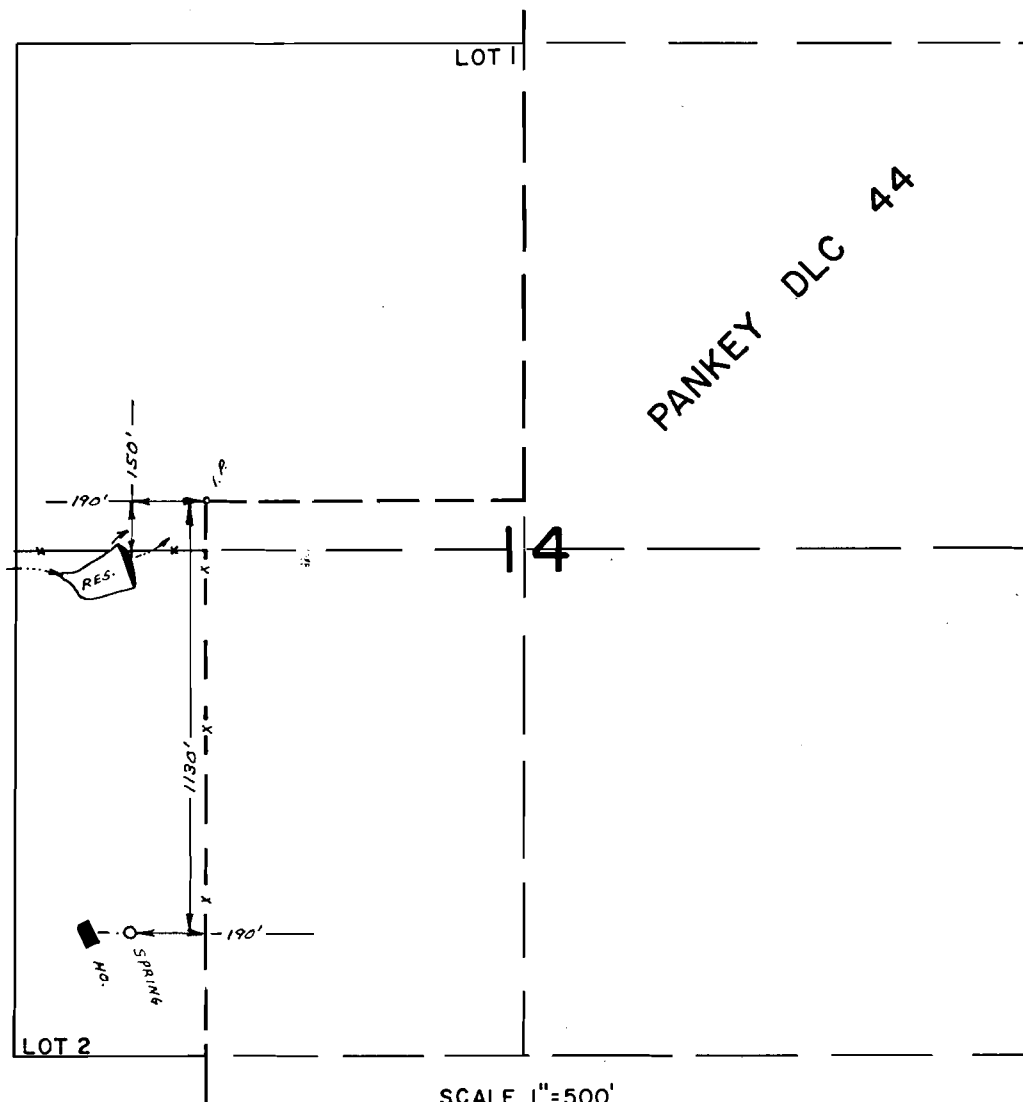

SCALE 1"=500'

FINAL PROOF SURVEY
UNDER

Application No. R-53011 53012 Permit No. R-6421 40309
IN NAME OF

DALE A. NEWTON

Surveyed APR. 14. 1977. by L.H. NUNN