


T.6S.,R.6W.,W.M.

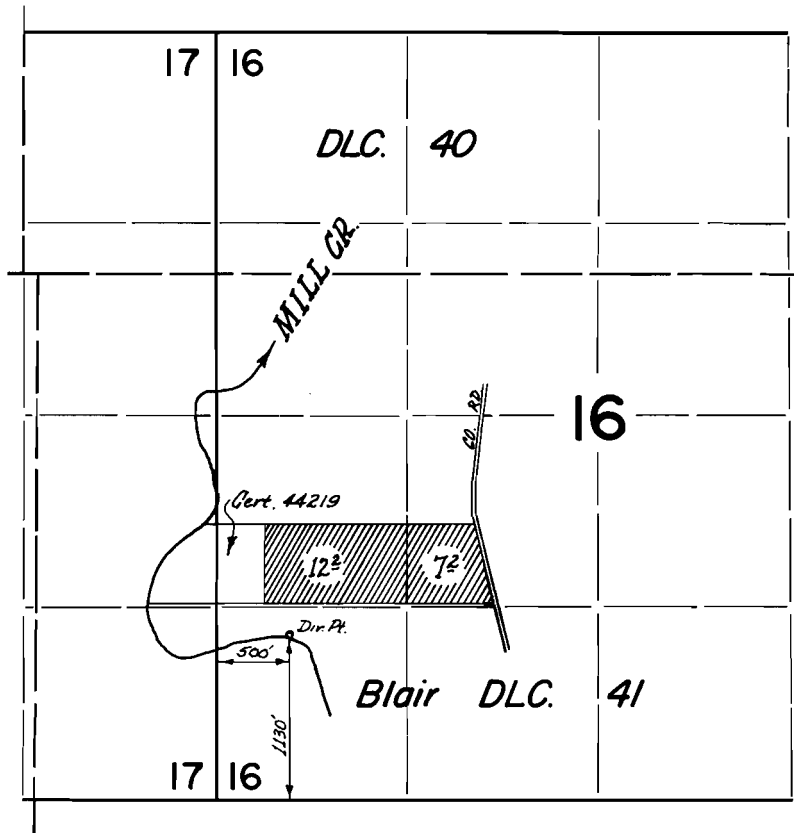

**FINAL PROOF SURVEY**  
UNDER

Application No. 53376 Permit No. 39732  
IN NAME OF

LESTER C. & SANDRA L. MORITZ

Surveyed Aug. 9 1977, by L.M. TOLL