


T.6S. R.5W. W.M.

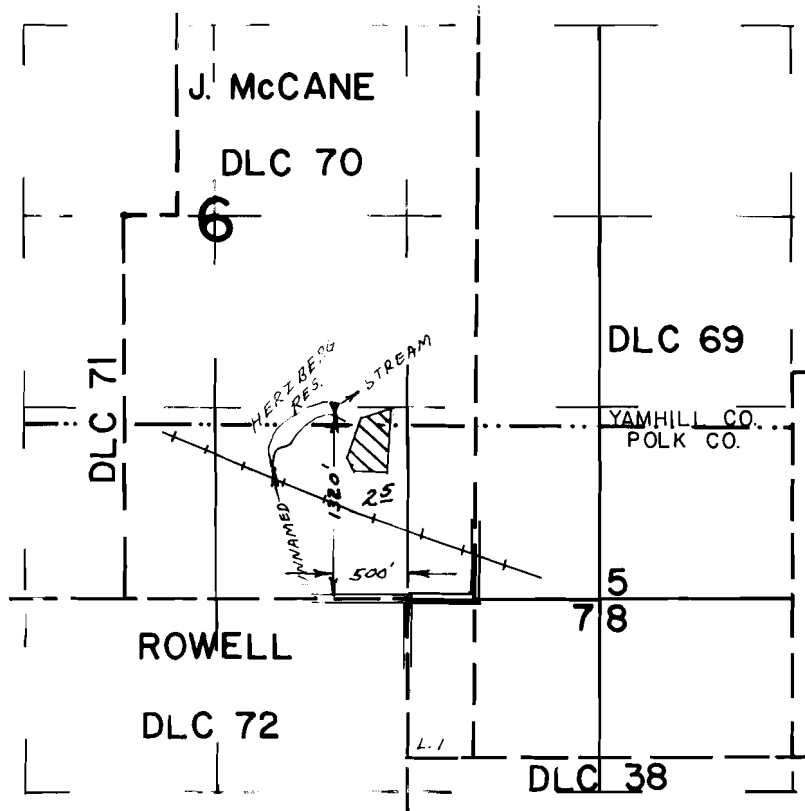

FINAL PROOF SURVEY
UNDER

R-54111 R-6444
Application No. 54112..... Permit No. 40437.....
IN NAME OF

.....**ANDREW HERZBERG**.....

Surveyed AUG. 10. 1977., by L.H. NUNN.....