


T.9S. R.6W.W.M.

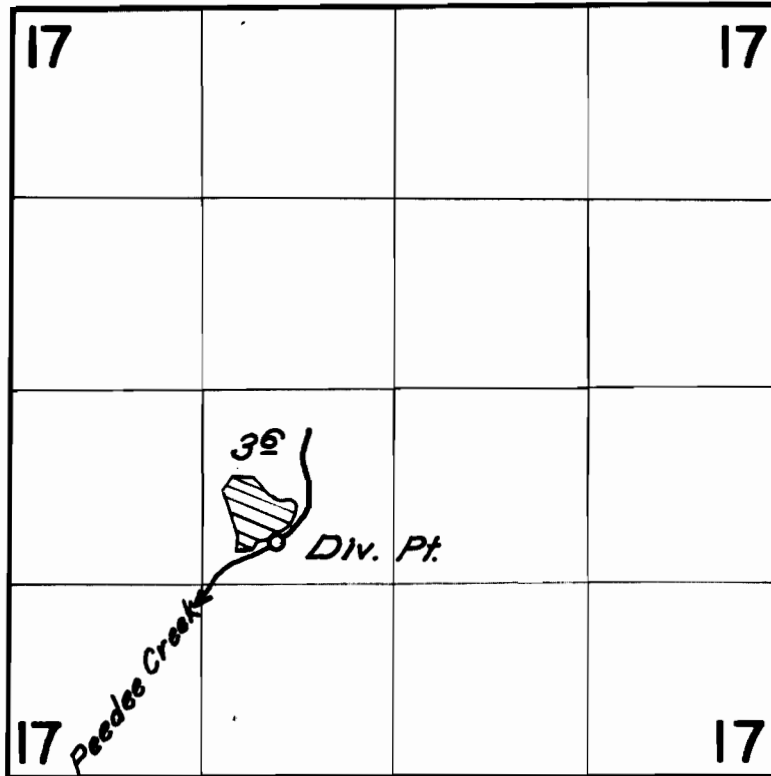

FINAL PROOF SURVEY
UNDER

Application No. *32390* Permit No. *25577*.
IN NAME OF

M.S. Eakin

Surveyed *3 July* 1962, by *Carl R. Baker*