T.2&3S.R.45E.W.M.

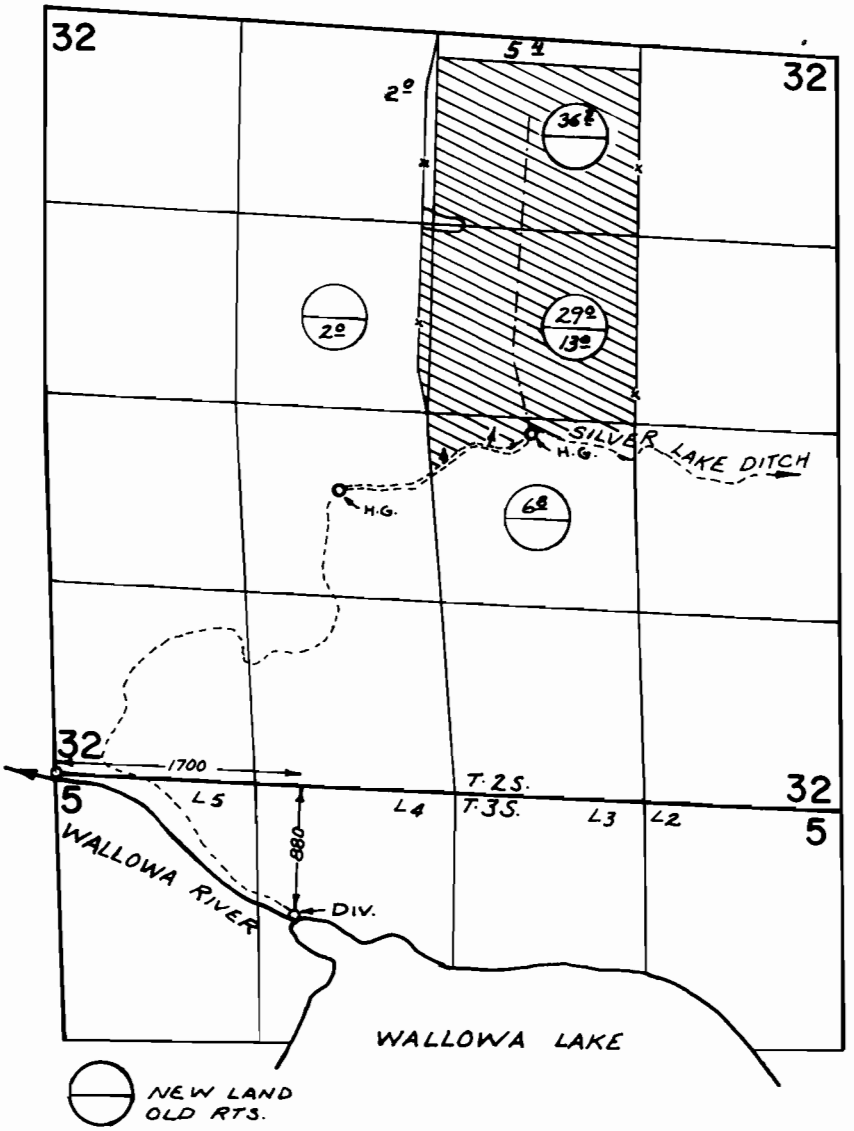

FINAL PROOF SURVEY
UNDER

Application No. 50794 Permit No. 38354
IN NAME OF

ANNABEL LEWIS

Surveyed SEPT. 28 1976, by R. MUCKEN

BBA-3MM-80