


T.2N.,R.12E.,W.M.

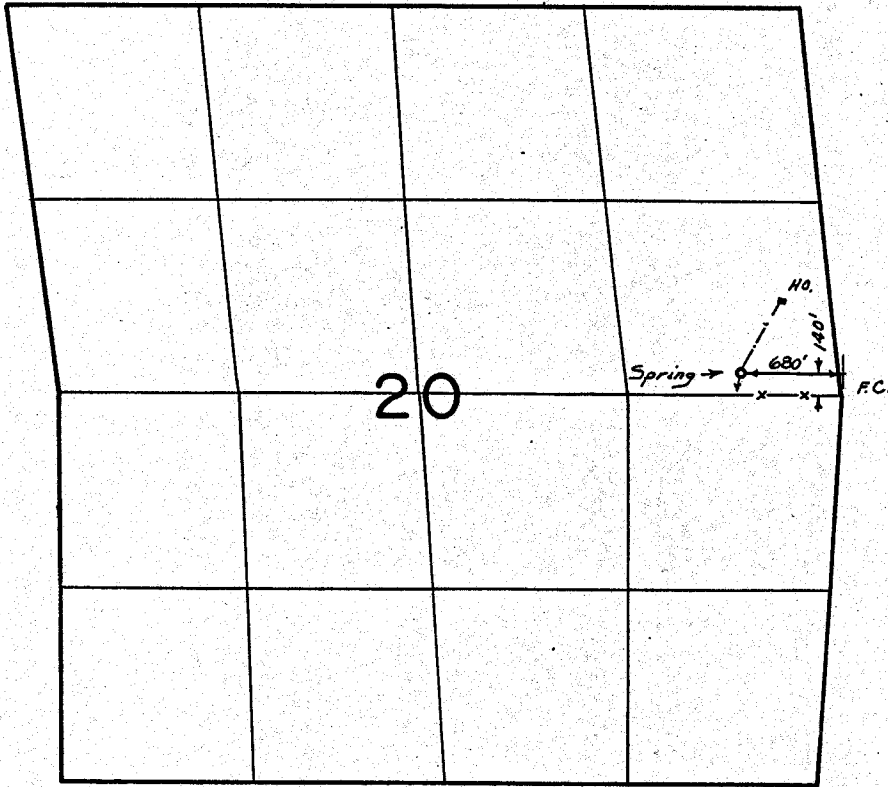

FINAL PROOF SURVEY UNDER

Application No. 55162 Permit No. 41460
IN NAME OF

Thomas Leedom

Surveyed Mar 29, 1978 by L. Nunn