


T.1S., R.2W., W.M.

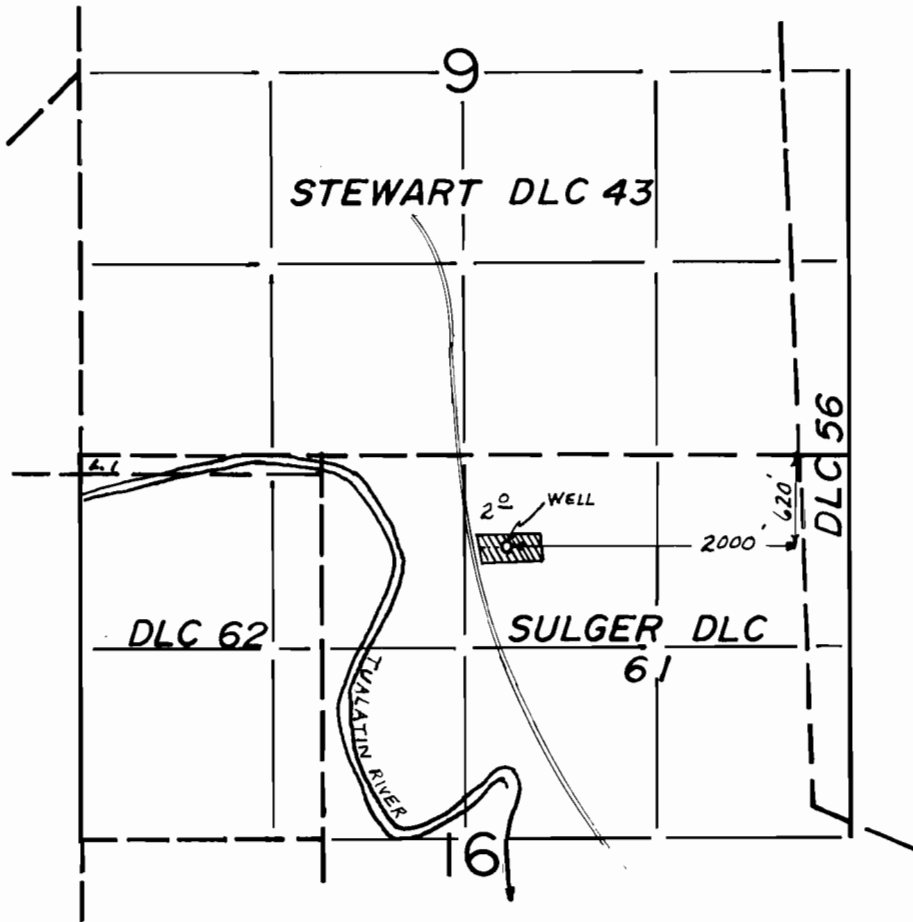

FINAL PROOF SURVEY
UNDER

Application No. G-7010 Permit No. G-6510
IN NAME OF

RICHARD C. LEWIS

Surveyed May 5 1977, by D.M. NORBY