


# T. 15. R. 2W. W.M.

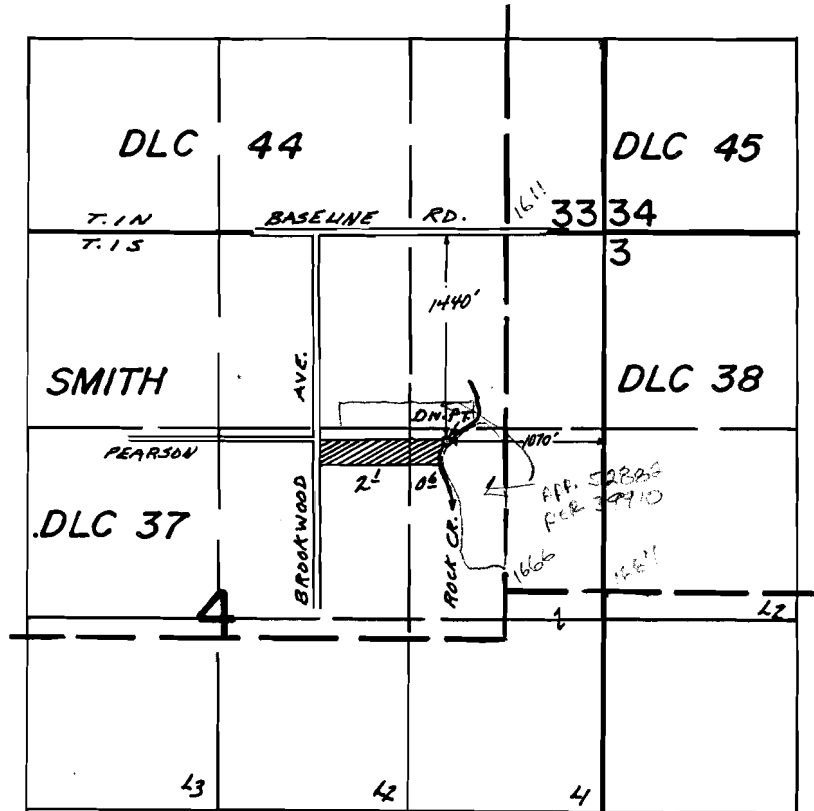

+ 1610

+ 1672

## FINAL PROOF SURVEY UNDER

Application No. 48314... Permit No. 36279...  
IN NAME OF

.....DAVID HOLSCHER.....

Surveyed MAY..6.... 1977., by D.M.NORBY.....