


T. 1S. R. 2W. W.M. ⁺¹⁹⁰⁶

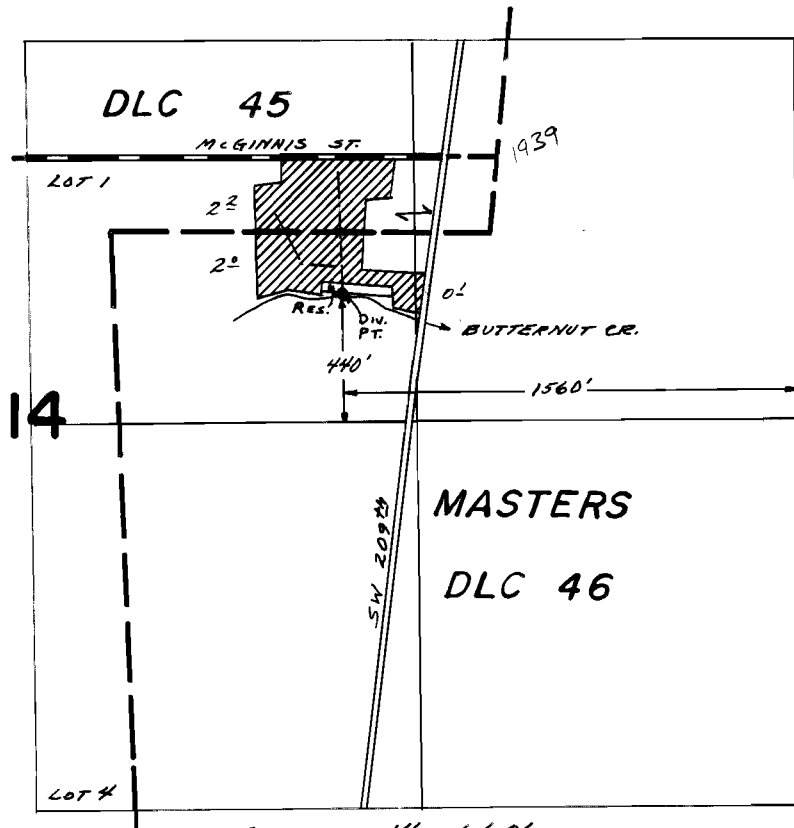

SCALE - 1" = 660'

DIV. FROM RES. LOC: 460' N. & 1500' W. FROM E 1/4 COR. SEC. 14

FINAL PROOF SURVEY
UNDER

²⁰²¹¹
Application No. 53345 R-53344 R-6336
Permit No. 39578
IN NAME OF

ROBERT WITZIG

Surveyed MAY 6 1977, by D.M. NORBY