


T.1S. R.3W. W.M.

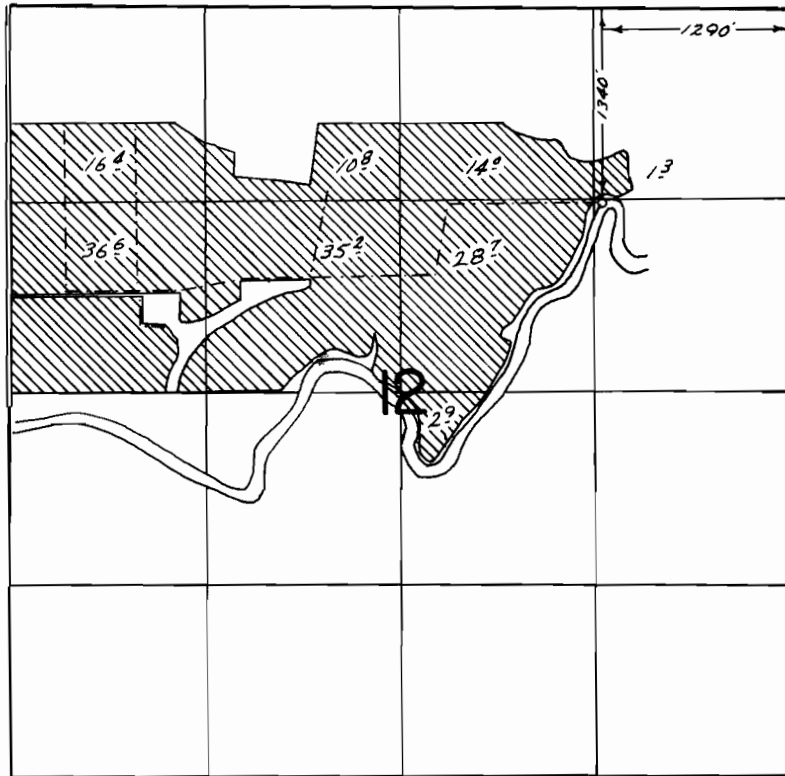

FINAL PROOF SURVEY UNDER

Application No. 41753... Permit No. 31168...
IN NAME OF

.....
WALTER ERDMAN
.....

Surveyed Sep. 5... 1974, by R. G. MUCKEN