


T.4S. R.5W. W.M.

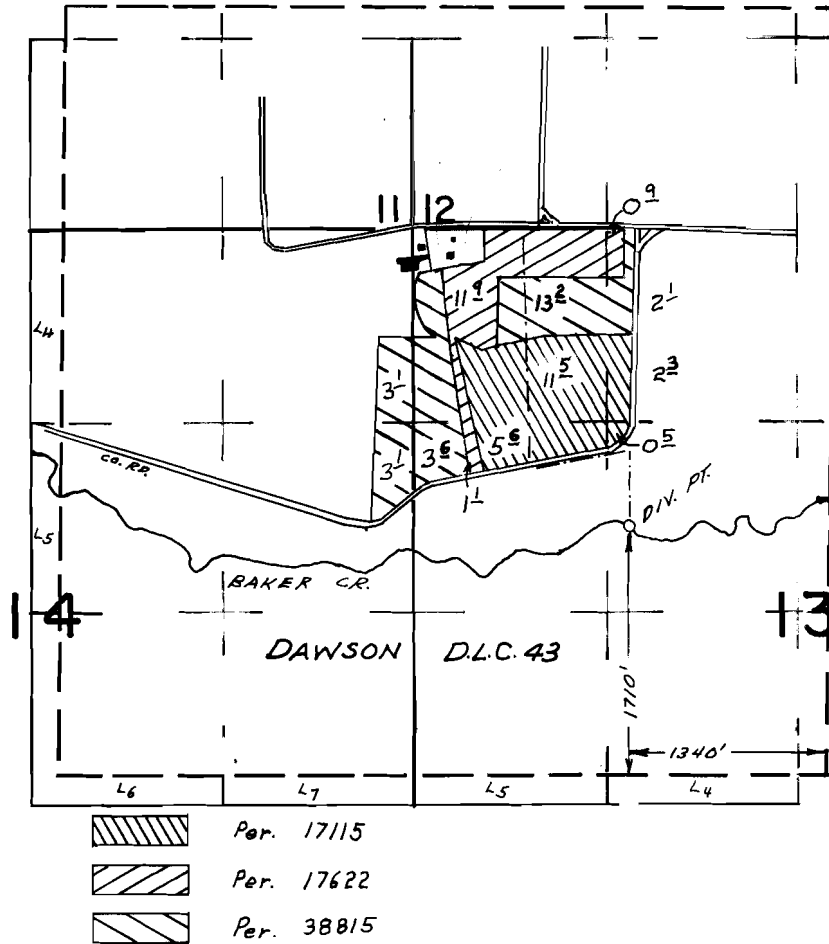

FINAL PROOF SURVEY UNDER

TRANSFER 3316
Application No. 53337... Permit No. 38815...
IN NAME OF

CALVIN E. VAN DER VEEN

Surveyed AUG. 11, 1977, by L.H. NUNN