


T. 3S., R. 5W., W.M.

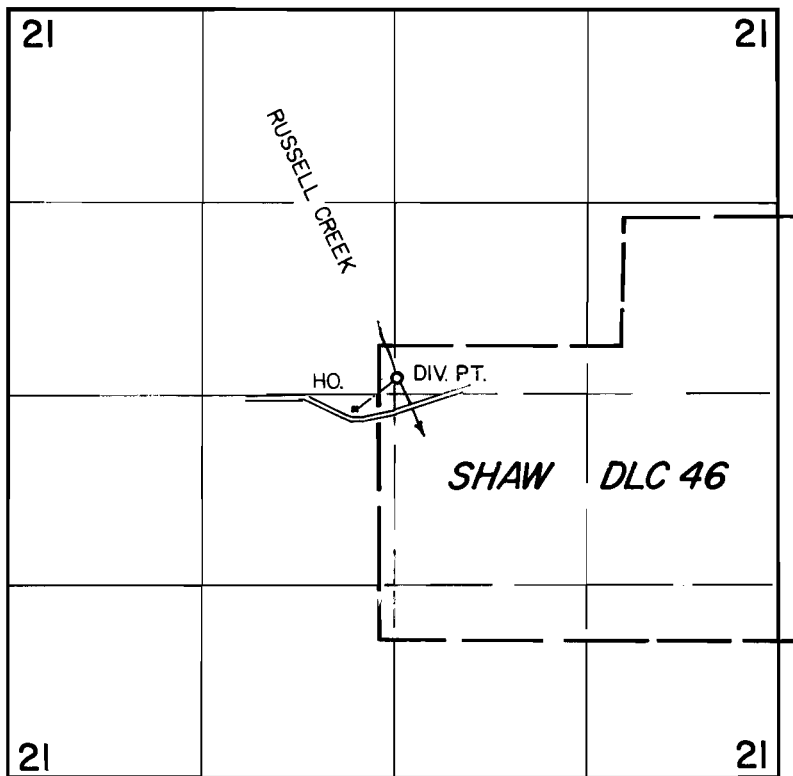

DIV. PT. LOC.: 230' S., & 130' E., From the most Westerly NW Cor. DLC 46

FINAL PROOF SURVEY
UNDER

Application No. 53393 Permit No. 39740

IN NAME OF

Irene F. Kenner

Surveyed Mar. 22, 1978 by L. Nunn