


# T.4S. R.5W., W.M.

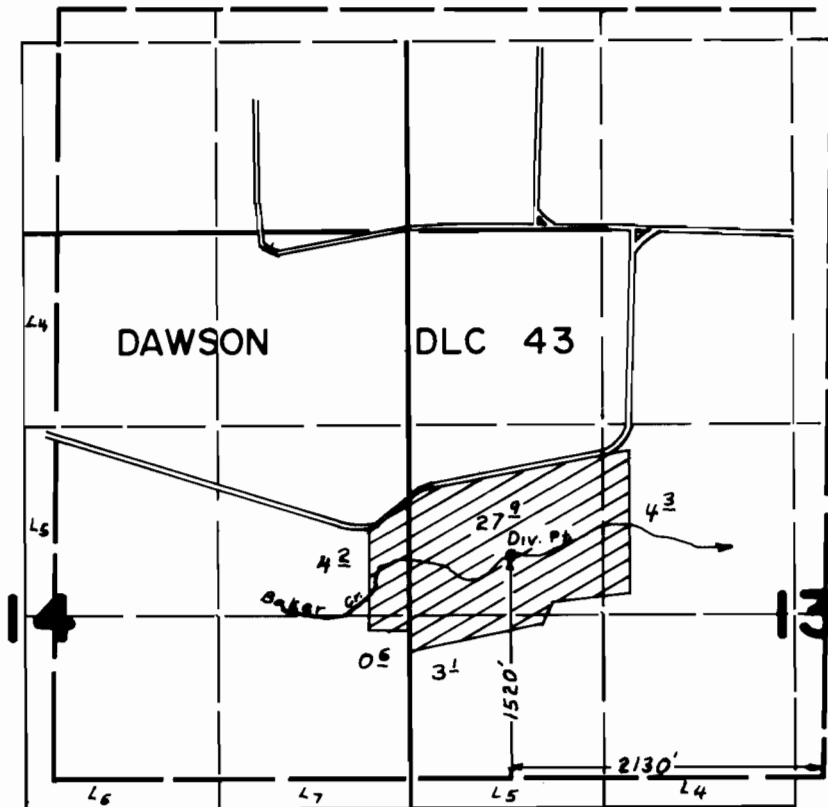

## FINAL PROOF SURVEY UNDER

Application No. 21757..... Permit No. 17115.....  
IN NAME OF

..... JOHN MAGEE .....

Surveyed APR. 3. 1947., by J.E. BUNNELL.....