


T.12S.R.5W.W.M.

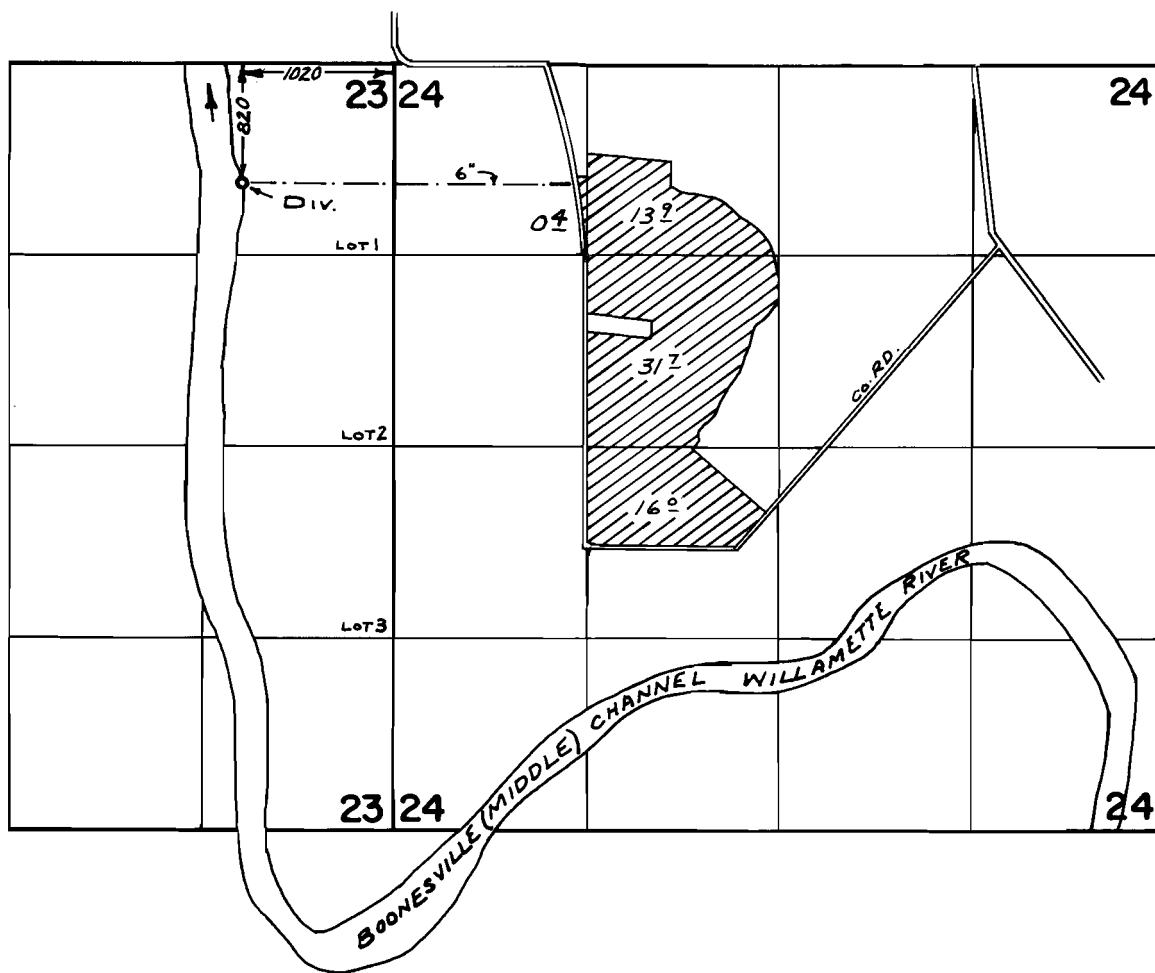

FINAL PROOF SURVEY UNDER

Application No. 54549 Permit No. 40935
IN NAME OF

WUTZKE FARMS

Surveyed AUG. 15, 1977, by BOB BARWIN