


T.4S. R.2E.W.M.

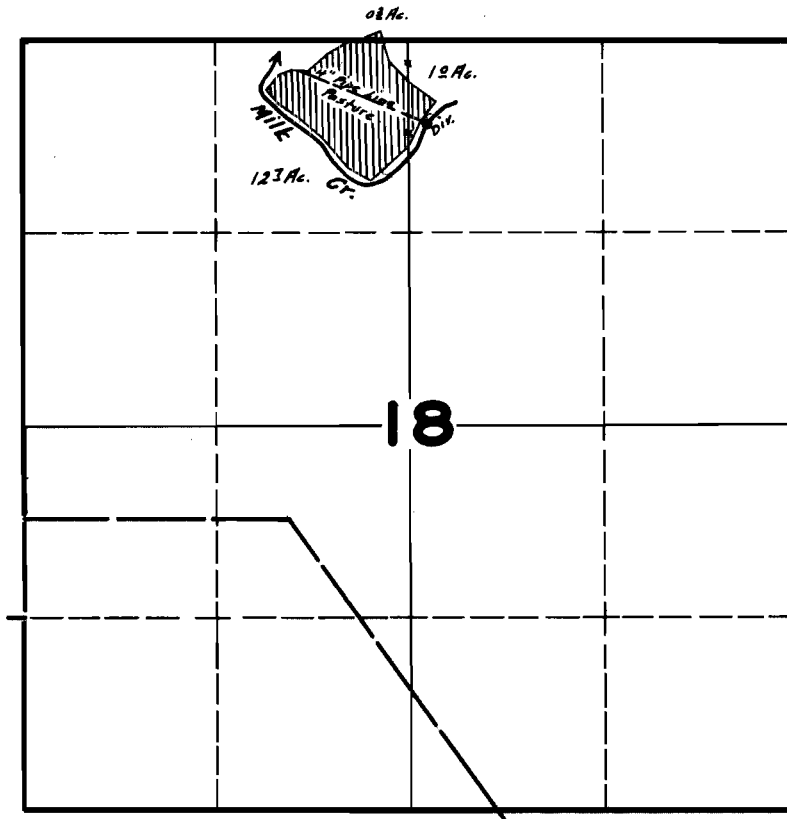

FINAL PROOF SURVEY UNDER

Application No. 19507 Permit No. 15102

IN NAME OF

RUSSELL W. SCHULTZE

Surveyed JUNE 23 1945, by James C. Bunnell