


T.4S.R.2E.W.M.

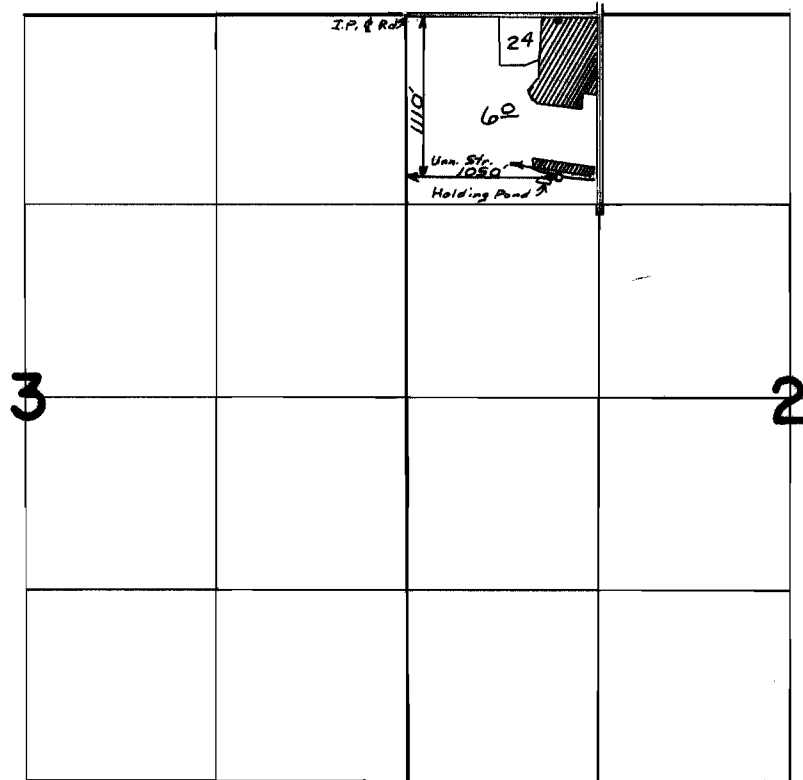

FINAL PROOF SURVEY
UNDER

Application No. 38924 Permit No. 28967
IN NAME OF

Owen Dunlap

Surveyed Oct. 19, 1967, by W. J. Ruppert