


T.4N. R.10W. W.M.

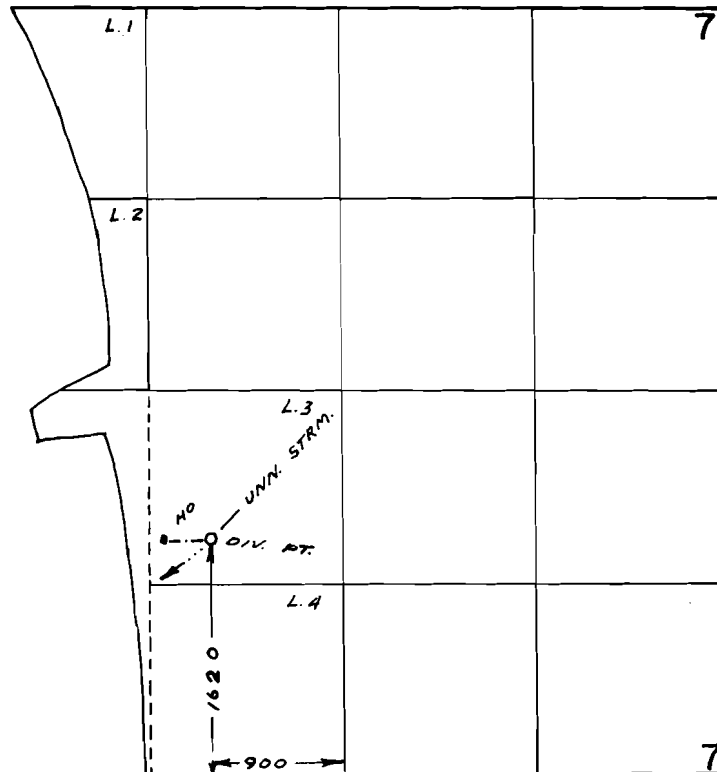

FINAL PROOF SURVEY
UNDER

Application No. 54249 Permit No. 40633
IN NAME OF

Mrs. Jeannette Goodrum

Surveyed JULY 27 1977, by L.H. NUNN