


T.29S. R.15W. W.M.

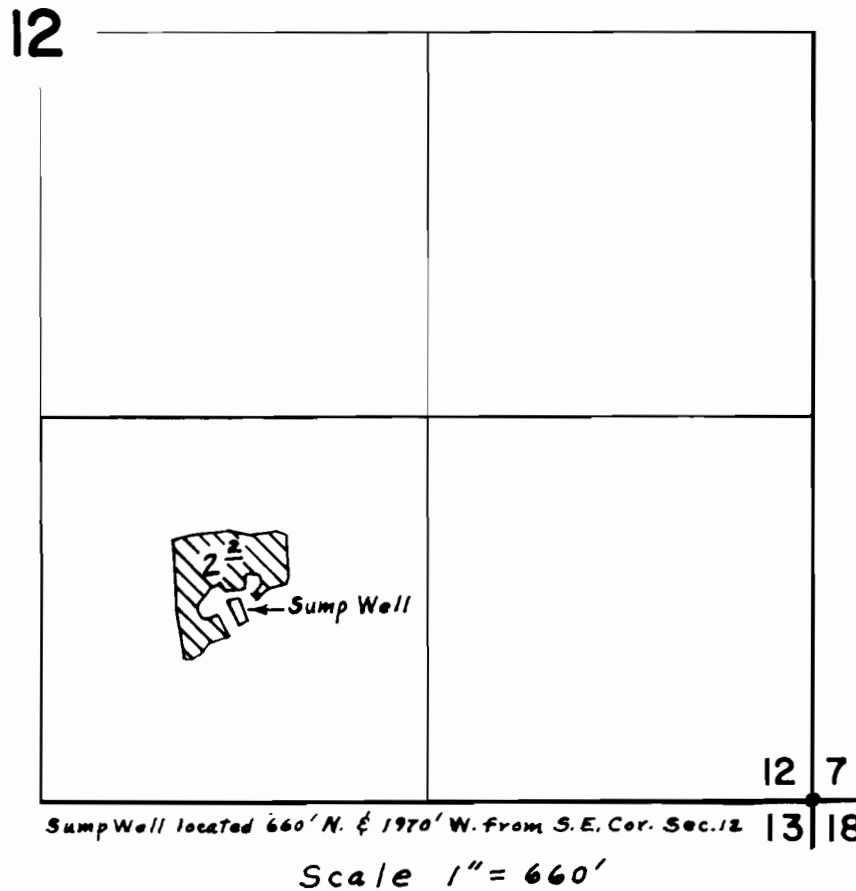

FINAL PROOF SURVEY
UNDER

Application No. G-5906 Permit No. G-5244

IN NAME OF

DOROTHY M. RAY

Surveyed Aug. 30, 1976, by L. E. Gould