


C-48227

T16S. R.23E. W.M.

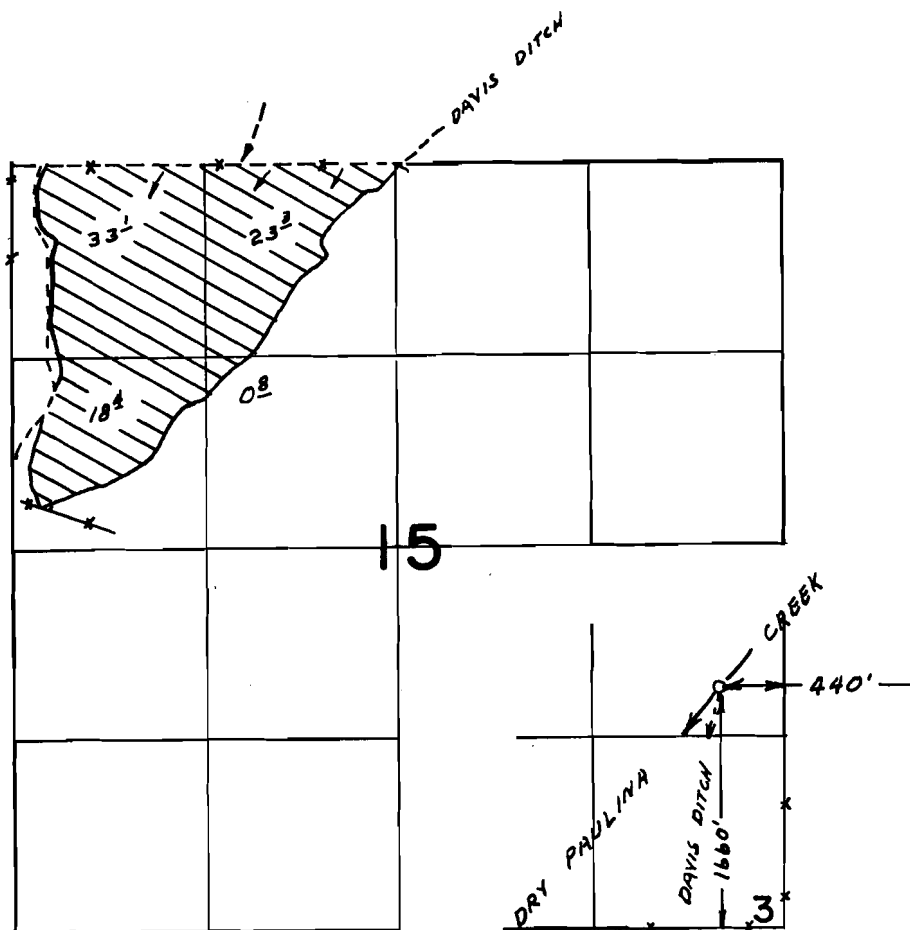

**FINAL PROOF SURVEY**  
UNDER

Application No. 37729... Permit No. 28124....  
IN NAME OF  
LOWELL CONGLETON  
..... ESTATE OF CHARLES S. CONGLETON...

Surveyed JUN. 7.... 1978, by L.H. NUNN.....

1978-P  
28124