


T.23S. R.7W. W.M.

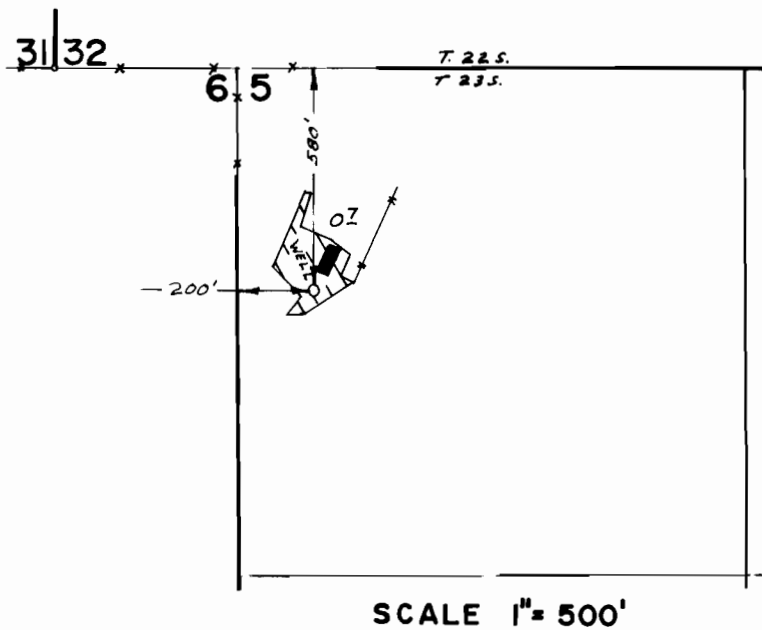

FINAL PROOF SURVEY UNDER

Application No. G-7053. Permit No. G-6538
IN NAME OF

..... EARL K. HAND

Surveyed APR. 21. 1977. by L.H. NUNN.....