


T.33S., R.7W., W.M.

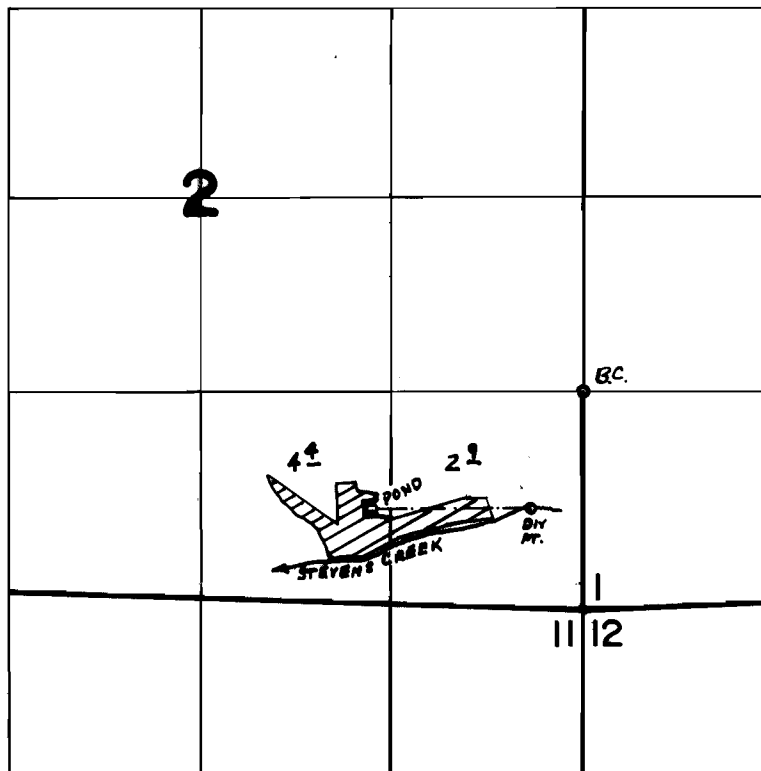

DIV. LOC. 800' S. & 350' W FROM S.E. $\frac{1}{4}$ COR. SEC. 2

FINAL PROOF SURVEY
UNDER

Application No. 44685.. Permit No. 33456..
IN NAME OF

...RICHARD W. LANDWEHR.....

Surveyed May 11, 1977, by D. NORBY.....