


T.32 S. R.4 W. W.M.

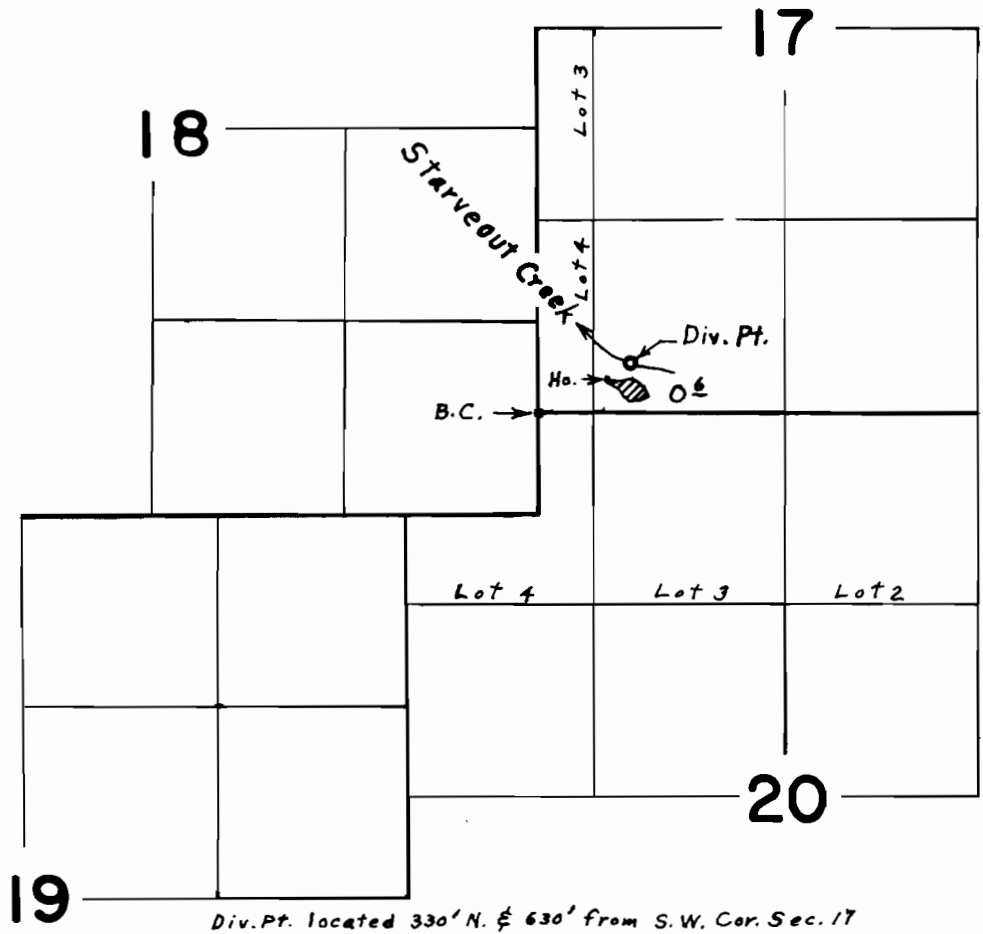

FINAL PROOF SURVEY
UNDER

Application No. 50208. Permit No. 37911...
IN NAME OF

.....JUDY PETERS AND DONALD POWERS.....

Surveyed May 13, 1976, by L. E. Gould.