


T.29S. R. 7W.W.M.

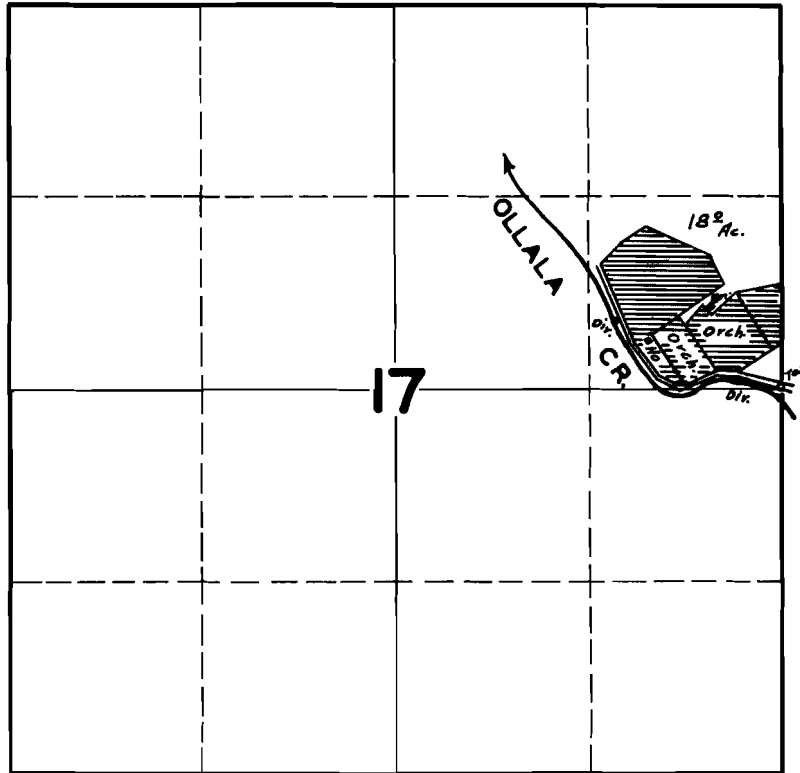

FINAL PROOF SURVEY
UNDER

Application No. 20519 Permit No. 16021

IN NAME OF

WALTER C. WILSON

Surveyed JUNE 5, 1947, by JAS. E. BUNNELL